

CERTIFIED LAND CORNER RESTORATION

Index No. V-1

State of Wisconsin

County of Oneida } ss.

I, Phillip T. Hansen, do hereby

certify that on the 2nd day

of March 19 78, I found

evidence of the Section Corner

corner of Sections 25, 36, 30, 31

Township 37, North, Range

10 & 11 East, Fourth Principal Meridian,

as described hereon; and that from this evidence

I established a new monument and accessories

as described hereon to perpetuate the original



location of this corner.

Resident witnesses:

Glen Barker

Jim Claflin

Herb Wagoner

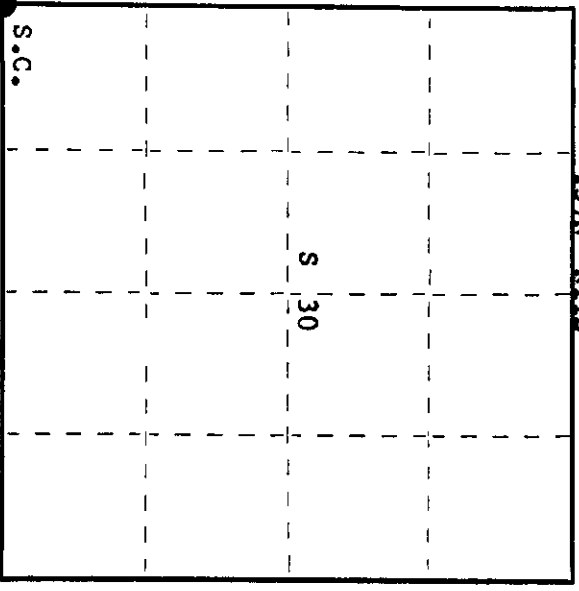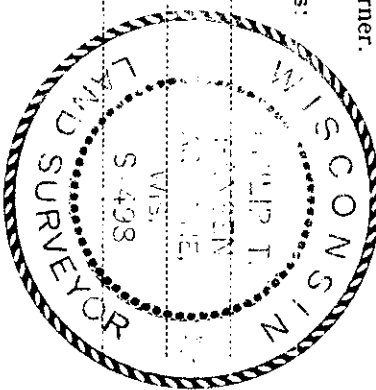

○ = Corner monument restored.

History of original corner establishment:

Original corner established by Hiram C. Fellows, Government Deputy Surveyor, in 1858 from which cedar 10" bears S71°W, 3 links; cedar 10" N50°W 3 links; cedar 12" N41°E 19 links; ash 10" S52°E, 19 links.

Corner recovered by V. Maine, county surveyor, in 1935.

Corner recovered in 1958 by H.C. Lawrence, Registered Land Surveyor. Set cedar post from which black ash 9" bears N58°W, 39 links; black ash 9" N18°E, 53 links.

Description of corner evidence found:

Recovered Maine's 2 1/2" iron pipe with screw on brass cap, stamped: Projects 18" above ground.

Also recovered a very old 5" squared cedar post, scribing on all four sides, no longer legible.

H.C. Lawrence's 5" cedar post, squared and scribed S31-S30 R11E - S25 T36N - S36 R10E

Pipe and post are in a radius of one link.

Recovered H.C. Lawrence's BT's - black ash 9" (10") N58°W (N55°W) (40.5 links) distance is to iron pipe; black ash 9" (10") N18°E, 53 links, scribed S30 NBT, distance is to iron pipe.

Description of monument and accessories established to perpetuate the original location of this corner.

Pipe is in perfect condition and securely set. It was left in place, also left both posts as we found them.

NBT's - black ash 9" S18°E, 50.8 links, scribed S.C. BT. black ash 8" S19°W, 35.3 links, scribed S.C. BT.

NBT's are in reference to iron pipe.

Dated at Rhinelander, Wis., this 23rd day of March, 19 78

Signature Phillip T. Hansen Title Registered Land Surveyor Registration No. S-498
(County Surveyor, Registered Land Surveyor, or other duly authorized official)

Office of Register of Deeds, County of Oneida, I hereby certify that the within instrument was filed in this office for record on the 10th day of April, 19 78 at 10:30 o'clock a. M.

Deane George Kuehn
(Register of Deeds)

By _____ Deputy

3710250000