U.S. PUBLIC LAND SURVEY MONUMENT RECORD

Note: This form is intended and designed to fulfill all requirements of Wisconsin Administrative Code, Chapter A-E 5.02, U.S. Public Land Survey Monument Record (3) (a) (b) (c) (d) (e) (f) (g) (h) (i). An additional sheet may be added if necessary to conform with said requirements.

(a) Corner location: Township 37 North

Range 10 East/~~West~~

Town/City/Village Stella

County Oneida

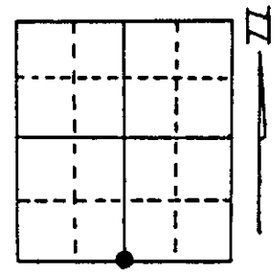

(b) (f) (g) (h) Description of monument found at this corner and if it was accepted, state all evidence (material, testimonial, occupational, plats, records, other monuments) used as a basis for accepting. If not accepted or if nothing was found, state evidence used as basis for establishing location. If reestablished through lost corner proportionate methods, indicate all monuments, distances and directions used to establish. NOTE BELOW: **

Recovered F.R. Wincentsen's 2½" well point and old B.T.s. Aspen 8" N73W 24 lks, now a 12' stub scribing visible. Aspen 10" S37E 50 lks, now a decayed stump. Dec. 1948 Wincentsen ran between the SW section corner and the SE section corner of section 25 for a total distance of 83.00 chs. (5478.00'). Set 1/4 corner 41.50 chs. (2739.0') intermediate. Resurvey of the above. Have a total distance of 82.953' chs (5474.87'). Have positioned the 1/4 corner to be 2742.98' of the SW section corner and 2731.89' of the SE section corner. 1/4 corner is not of proportion measurement but will accept on the basis Wincentsen subdivided section 25 from the central of this position and has been of record for 39 years.

** Original corner established by Wm. E. Dougherty, Deputy Surveyor in 1863 from which birch 12" bears S16W and white pine 10" bears S10W 35 lks.

See Back

(c) (d) (e) Plan view of corner with ties to at least 4 witness monuments. If in disagreement with previously established corner, show the distances between the two corners and also indicate the ties to the disputed corner.

2¼" alum. Oneida Co. Mon.

T 37N R10E
1/4 S 25
1/4 S 36
1987
S-1682

Magnet in base

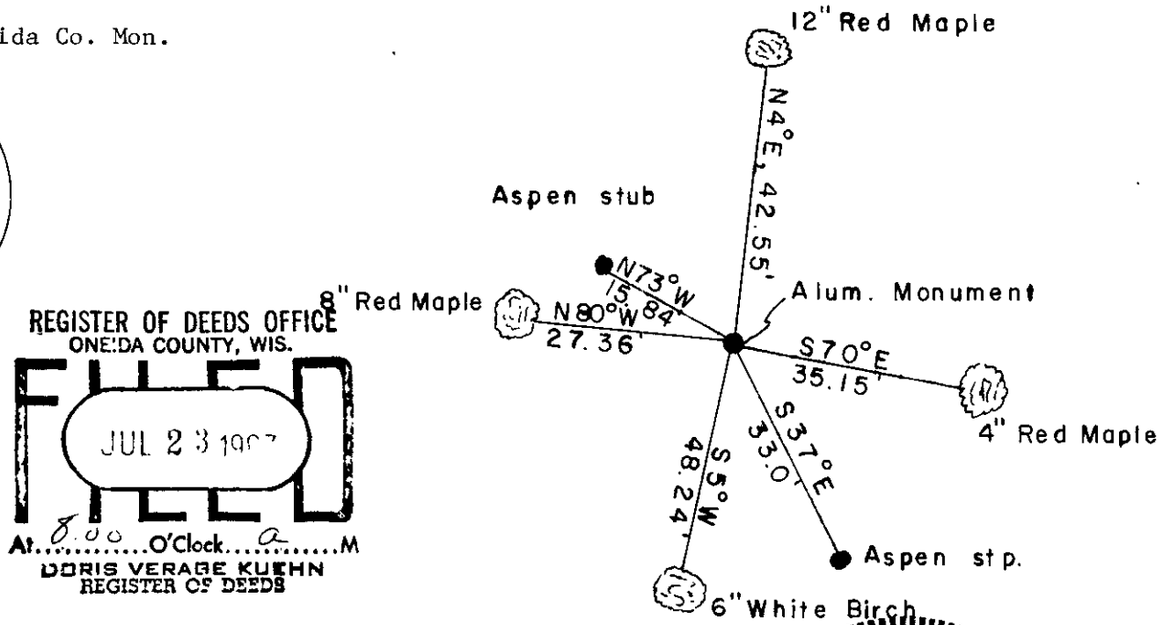

REGISTER OF DEEDS OFFICE
ONEIDA COUNTY, WIS.
FILED
JUL 23 1987
At 8:00 O'Clock a M
DORIS VERAGE KUEHN
REGISTER OF DEEDS

(i) I, Glen Barker (type or print name) certify that the corner location on this record was determined by me or under my direction and control and that this U.S. Public Land Survey Monument Record is correct and complete to the best of my knowledge and belief.

Glen Barker — 7/7/87

Signature — Date

WISCONSIN
GLEN BARKER
S-1682
CRANDON
WI
LAND SURVEYOR

Index No. V-23

3710250020