

M.C. between Sec. 25 & 30

Original Tamarack
Stump

S 67° W 66.0'

H.C. Lawrence's Post recovered
Set 1/2" X 12' Rebar with 3-1/4"
alloy cap. Established from
original B.T.

S 16° E 52.10'

V.A. Mainé's 2-1/2 I.P.
with Brass Cap.

M.C.

Resurvey Dist.
2604.92'

Original Dist
2607.00'

1/4 25 | 30

U.S. PUBLIC LAND SURVEY MONUMENT RECORD


Note: This form is intended and designed to fulfill all requirements of Wisconsin Administrative Code, Chapter A-E 7.08 U.S. Public Land Survey Monument Record (3) (a) (b) (c) (d) (e) (f) (g) (h) (i). An additional sheet may be added if necessary to conform with said requirements.

(a) Corner location: Township 37 North

Range 10 East/West

Town/City/Village Stella

County Oneida

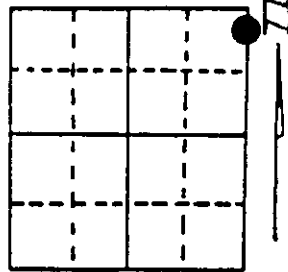

Section 25

(b) (f) (g) (h) Description of monument found at this corner and if it was accepted, state all evidence (material, testimonial, occupational, plats, records, other monuments) used as a basis for accepting. If not accepted or if nothing was found, state evidence used as basis for establishing location. If reestablished through lost corner proportionate methods, indicate all monuments, distances and directions used to establish. Indicate type of monument found or set and sign post.

1860 - Hirman Fellows established this corner at 79.5 chains on shore of lake, set a wood post with two BTs:

7" Tamarack, S67°W, 100 Links 8" Tamarack, N60°W, 731 Links

1930s - Vern Maine set a 2" iron pipe with brass cap by proportional measure.

1949 - Lawrence found remains of original BT S67°W, 100 links and restored corner by setting a wood post.

12/22/1989 - Glen Barner found Maine's corner and Lawrence's corner and restored same by placing a 1/2" x 12' rebar with 3 1/4" aluminum cap and four new ties:


- 1 1/4" iron pipe, S14°W, 23.61'
- 1 1/4" iron pipe, S38°W, 34.76'
- 1 1/4" iron pipe, S64°W, 36.80'
- 1 1/4" iron pipe, N79°W, 27.14'
- 2" iron pipe/B.C., S16°E, 52.10'

3/20/1992 - Milo E. Stefan found Barner's work under water and ice. As this position cannot be occupied I chose to set two Witness Corners on the Section Line Southerly.

(c) (d) (e) Plan view of corner with ties to at least 4 witness monuments. If in disagreement with previously established corner, show the distances between the two corners and also indicate the ties to the disputed corner.

- 1) North W.C.M.C. - 2" x 30" aluminum monument
- 2) 3" B. Fir, S47°E, 9.40'
- 3) 8" W. Birch, S80°W, 9.01'
- 4) 6" W. Birch, N67°W, 23.48'
- 5) 5" B. Fir, N32°W, 18.19'
- 6) Plastic sign post, East, .6'

- 1) South W.C.M.C. - 2" x 30" aluminum monument
- 2) 6" Red Maple, N68°E, 19.65'
- 3) 8" B. Fir, S12°W, 19.41'
- 4) 5" W. Birch, N81°W, 14.61'
- 5) 11" Red Maple, N3°W, 27.76'
- 6) Plastic sign post, East, 1.0'

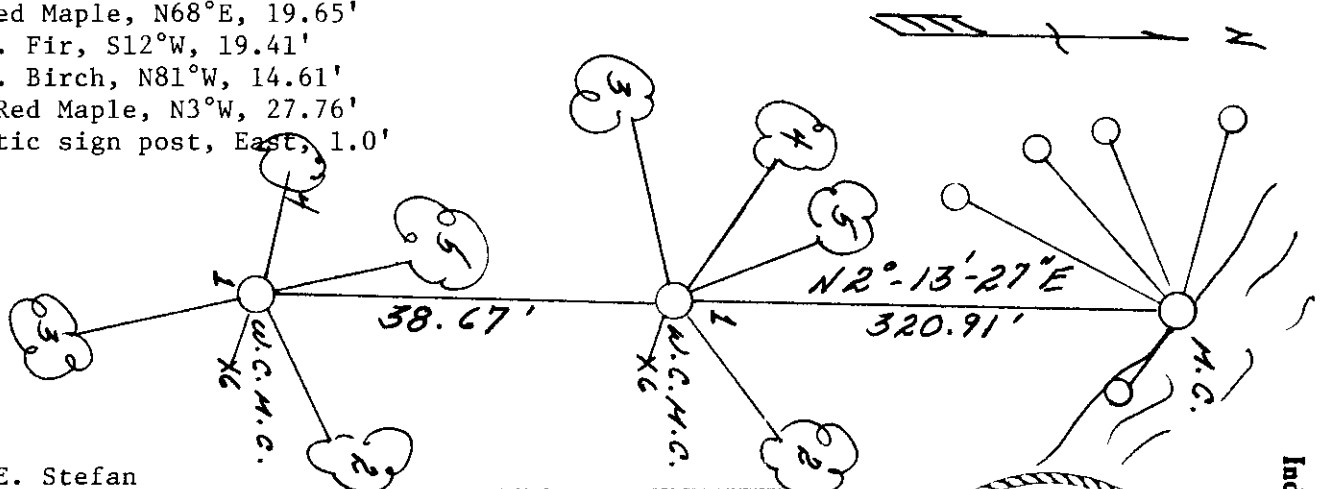

(i) I, Milo E. Stefan

(type or print name) certify that the corner location on this record was determined by me or under my direction and control and that this U.S. Public Land Survey Monument Record is correct and complete to the best of my knowledge and belief.

Milo E. Stefan
Signature

August 5, 1992
Date



Index No. R. S - 25