

This form is intended to fulfill the requirements of Chapter A-E 7.08 (3)(a) thru (i) U.S. Public Land Survey Monument Location Record, Wisconsin Administrative Code. Use the reverse side of form for continuation.

**U.S. PUBLIC LAND SURVEY MONUMENT LOCATION RECORD**

Recorders Data

USPLS CORNER: CENTER 1/4 CORNER SECTION: 26 TOWNSHIP: 37 NORTH RANGE: 10 EAST

NAME OF WATERWAY FOR M.C. CORNER : N/A SECTION LINE: N/A

(CITY)(VILLAGE)(TOWN) OF: STELLA COUNTY OF: ONEIDA

Description of monument found or placed and all other evidence used as the basis for monument location; including monuments and related measurements required if the corner location was reestablished by lost corner proportionate methods. Also indicate name of original surveyor, original survey date and the corner monument, bearing trees, witness or other reference monuments established; including measured bearing and distance ties, from available records.

**THIS CORNER RECOVERED AND PERPETUATED AT THE REQUEST AND APPROVAL OF ONEIDA COUNTY SURVEYOR MICHAEL ROMPORTL SUBSEQUENT TO PREVIOUS HIGHWAY IMPROVEMENT BY ONEIDA COUNTY.**

No record monument was observed nor detected with magnetic metal locator at this corner location within existing highway pavement area, so I reestablished the corner with a 7/16" dia. by 8" long galvanized spike driven flush with the pavement surface in accordance with 1973 Wisconsin DOT Preservation of Landmark record by Hess, RLS 666, filed as L-479 in Oneida County records. The corner falls 1.3' North of the South edge of 22' wide pavement.


I recovered all four(4) cast aluminum monuments with standard stamped Wis DOT cap undisturbed for corner location reestablishment purposes, which I set by proportion on a right line with transit between found witness monuments 3 and 6 noted below.

I left all reference monument caps open and flagged with blaze orange, and check measured all Wis DOT record tie distances except between witness monuments at 1 and 6 due to thick brushy conditions.

I set a standard white poly 'T' marker post 6" south of witness monument 6, 6" North of witness monument 3 and 17.5' South of spike at corner location.

This recovery completed August 25, 1999; there were no direct witnesses other than frequent vehicle drive-bys.

Plan view map of monument location with bearing and distance ties to a minimum of four(4) described witness or reference monuments of concrete, natural stone, iron, live bearing trees or equivalent material. If applicable, also show a minimum of two(2) bearing and distance ties to any other monument found and not accepted; including the bearing and distance from the accepted monument.

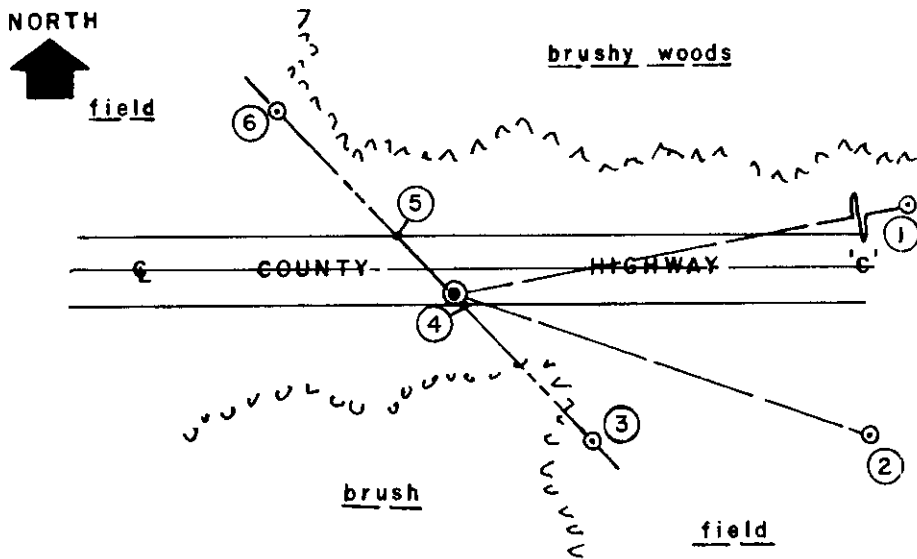


**WITNESS MONUMENT TIES:**

- ① Standard Wis DOT capped cast aluminum monument found 5' below grade N78°13'E 208.78' per record.
- ② Standard Wis DOT capped cast aluminum monument found flush S71°56'E 135.88' per record.
- ③ Standard Wis DOT capped cast aluminum monument found 5' below grade S43°15'E 62.51'(62.55' record).
- ④ 1/4" dia. by 2.5" long PK nail set at edge of pavement on right line.
- ⑤ Standard Wis DOT capped cast aluminum monument found 3" below grade N43°15'W 81.19'(81.25' record)

SCALE: 1" = 60'

Unless otherwise indicated, all bearing tree ties are to a .25" dia. by 2.5" long PK nail with a 1.25" dia. steel washer driven into unblazed right face and a .25" dia. by 2.5" long PK nail with a 2" dia. steel washer stamped BT is also driven into unblazed face of bearing tree at DBH; the basis for measured bearings is by compass to nearest degree and all tie distances are measured horizontal by steel tape corrected to nearest 1/100th feet at standard temperature of 68° F.


RLS SEAL:

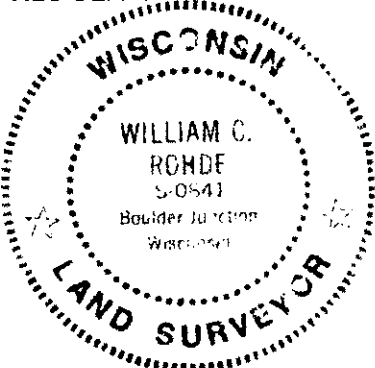

LAND SURVEYOR CERTIFICATE:

I, William C. Rohde, hereby certify that I am duly licensed as a Professional Land Surveyor in the State of Wisconsin; that this USPLS monument location was determined by me and/or under my direct supervision and control; and that this U.S. Public Land Survey Monument Location Record is true and correct to the best of my knowledge and belief.

Signed: *William C. Rohde*  
William C. Rohde RLS 841

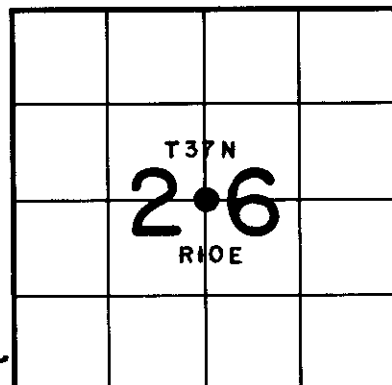

SECTION LOCATION MAP  
INDEX NO. T 19

3710262020