

U.S. PUBLIC LAND SURVEY MONUMENT RECORD

Instructions: This record shall show the location of the corner and shall include all of the following nine elements (a through i).

- (a) Identify the corner by reference to the U.S. public land survey system.


○ = Corner monument restored.

North-1/4 Corner

Sec 34 T 37 N, R 10 E

Type of Monument:

2-1/4" Aluminum pipe W/ 3-1/4" Alloy cap.

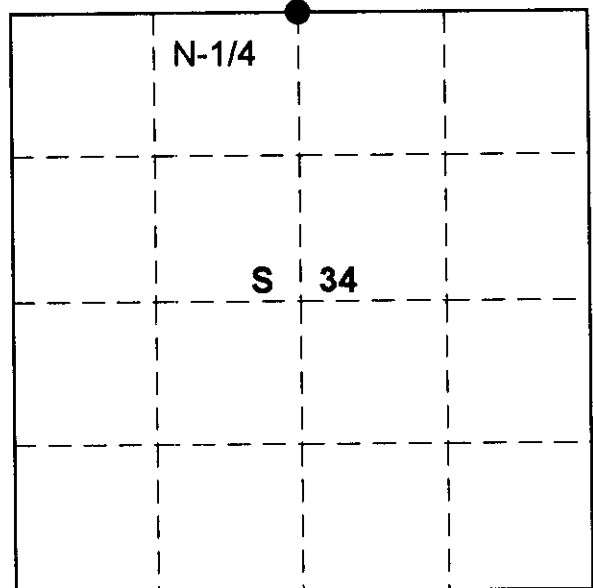

ONEIDA COUNTY

- (b) Describe any record evidence, monument evidence, occupational evidence, testimonial evidence or any other material evidence you considered, and whether the monument was found or placed.

Original corner established in 1860 by WM. F. Daugherty, Gov.t Deputy surveyor from which Birch 12" N14E 11 lks and White Pine 8" S25E 9 lks.

In 1915 D.H. Vaughan County Surveyor reestablished said quarter corner on a proportional measurement. Ran from northeast section corner to the northwest section 34, for a total distance of 82.56 chains, (5435.76') Set quarter corner 41.18 chains (2717.88') intermediate.

Searched for corner evidence and talked to land owners for information on said quarter corner to no avail. Reestablished quarter corner on a proportional measurement. Ran from the northeast section corner to the Recent established northwest section corner (see survey monument record of the northwest section corner) Of section 34, for a total distance of 5454.32' set quarter corner 2727.16' intermedite. Monument sets on the north edge of field and the east side of open wet marsh and pond. Same area as described In D. H. Vaughns 1915 notes. (See page two)

- (c) In the plan view drawing below, provide reference ties to at least 4 witness monuments, or, if the location is within a municipality, to at least 2 witness monuments. (Witness monuments shall be made of concrete, natural stone, iron or other equally durable material).

Describe witness monuments:

- (d) Show a plan view drawing depicting the relevant monuments and reference ties which is sufficient in detail to enable accurate relocation of the corner monument if the corner monument is disturbed. Indicate north.

Marked NBTs

- (1) White pine 6" N79E 48.78'
- (2) White pine 11' S74W 74.45'
- (3) White pine 5" N26W 40.08'

- Set a 3/4" rebar for reference monument South 21.36' Rebar has 1" plastic cap.

Monument Set

2-1/4' Alum. Pipe W/ 3-1/4" Alloy cap

