

This form is intended to fulfill requirements of Chapter A-E 7.08 (3)(a) thru (i) U.S. Public Land Survey Monument Location Record, Wisconsin Administrative Code. Use reverse side for geodetic location data and/or other continuation purposes.

U.S. PUBLIC LAND SURVEY MONUMENT LOCATION RECORD

Recorders Data

USPLS CORNER: EAST MC SECTION: 32 TOWNSHIP: 37 NORTH RANGE: 10 EAST
 NAME OF WATERWAY FOR M.C. CORNER: SNOWDEN LAKE SECTION LINE: NORTH
~~(CITY/VILLAGE/TOWN) OF:~~ STELLA COUNTY OF: ONEIDA

Description of monument found or placed and all other evidence used as the basis for monument location; including monuments and related measurements required if the corner location was reestablished by lost corner proportionate methods. Also indicate name of original surveyor, original survey date and the corner monument, bearing trees, witness or other reference monuments established; including measured bearing and distance ties, from available records.

Found and accepted an old 6" square concrete monument with standard Oneida County tablet in top stamped by Hall in 1933 and about 8" above existing grade; tablet is also stamped "Orig MC #19". The monument is tipped slightly toward existing lake shore, but the record ties check OK to tablet center mark.

In August of 1863, Daugherty/GLO set a wood post as the original meander corner and marked OBTs, a 14" Py N47°E 4 links and an 8" Py S41°E 5 links, all of which are now obliterated.

In 1933, Hall set and stamped the foregoing concrete monument.


In 1953, Crawford/BLM found and accepted Halls 1933 concrete monument with stamped Oneida County tablet in top as the original meander corner location during his BLM resurvey; and noted new BTs, a 12" Pn N54.5°E 31.5 links marked T37N R10E S29 MC BT, which I found OK as a 17" Pr and noted for new ties below, and he noted a 6" Pn S7.25°W 36.5 links marked T37N R10E S32 MC BT, which I found OK as a 13" Pr and noted for new ties below, all per Resurvey Plat filed as B-1729 and Field Notes filed as L-1034 Oneida County records.

In 1977, W. Bandow found and accepted the foregoing concrete monument MC per Plat of Survey filed as C-331 in Oneida County records; and the same monument was also found and accepted the same year by J. Rein per county plat of Paradise Acres.

In 1996, R. Brown found and accepted the foregoing concrete monument as the MC location per Plat of Survey 3492 filed in Oneida County records.

The MC monument is located on the southerly shore of Snowden Lake approximately midway between driveways to Fire No. 3242 and Fire No. 3252 northerly of County Highway 'C'. This recovery completed October 19, 1998; there were no direct witnesses.

Plan view map of monument location with bearing and distance ties to a minimum of four(4) described witness or reference monuments of concrete, natural stone, iron, live bearing trees or equivalent material. If applicable, also show a minimum of two(2) bearing and distance ties to any other monument found and not accepted; including the bearing and distance from the accepted monument.

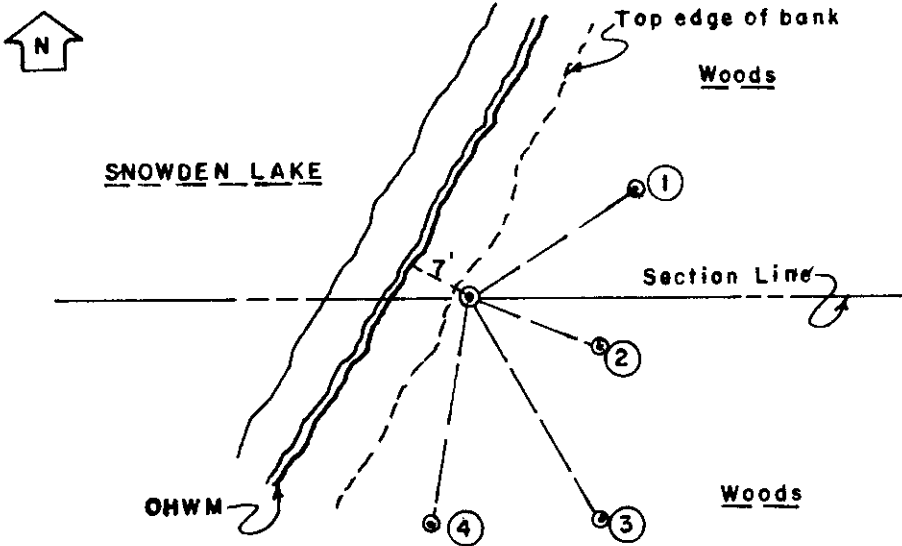

WITNESS MONUMENT TIES:

- ① Record BT 17" Pr N57°E 20.45' with old upper blaze shut but plain and lower blaze partly open with face and scribing plain. I nailed a standard Oneida County BT sign to SW face.
- ② New BT 13" Pr S68°E 14.52'.
- ③ New BT 16" Pr S29°E 26.93'.
- ④ Record BT 13" Pr S10°W 24.13' with old upper and lower face blazes shut but with plain overgrowth scars.


Standard white poly 'T' corner marker post set 1 foot SE of MC concrete monument.

The corner monument is about 7 feet SE of the southeasterly shoreline of Snowden Lake as now evidenced by OHWM.

SCALE: 1" = 20'

Unless otherwise indicated, all bearing tree ties are to a .25" dia. by 2.5" long PK nail with a 1.25" dia. steel washer driven into unblazed right face and a .25" dia. by 2.5" long PK nail is also driven into unblazed face of bearing tree at DBH; the basis for measured bearings is by magnetic compass to nearest degree and all tie distances are measured horizontal by steel tape corrected to nearest 1/100th feet at standard temperature of 68 degrees Fahrenheit.


RLS SEAL:

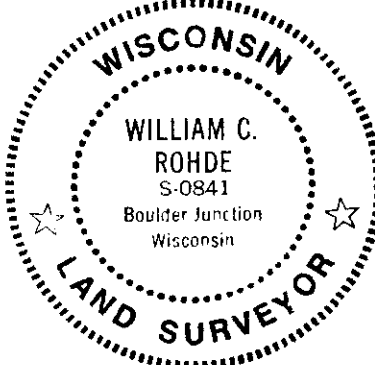

LAND SURVEYOR CERTIFICATE:

I, William C. Rohde, hereby certify that I am duly licensed as a Professional Land Surveyor in the State of Wisconsin; that this USPLS monument location was determined by me and/or under my direct supervision and control; and that this U.S. Public Land Survey Monument Location Record is true and correct to the best of my knowledge and belief.

William C. Rohde Date: 03-12-99
 William C. Rohde RLS 841

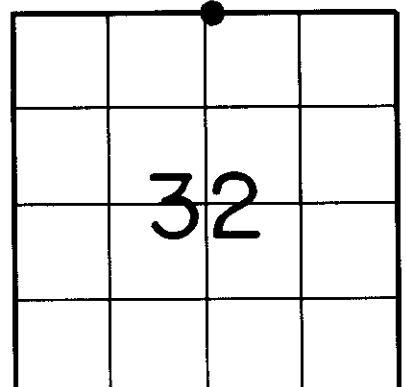

SECTION LOCATION MAP
 INDEX NO. V 7-8
 3710 29 0019