
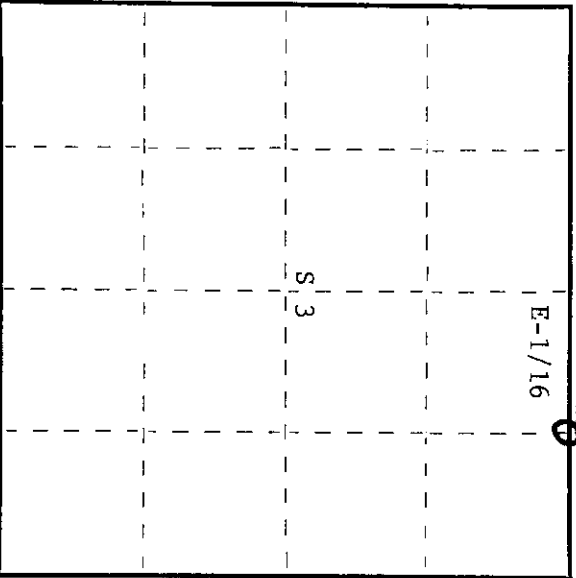


State of Wisconsin

County of Oneida } ss.

I Phillip T. Hansen do hereby certify that on the 10th day of May, 1975, I found evidence of the E-1/16 between corner of Sections 3 and 34 Township 36-37 North, Range 10 East, Fourth Principal Meridian, as described hereon; and that from this evidence I established a new monument and accessories as described hereon to perpetuate the original location of this corner.

Resident witnesses:

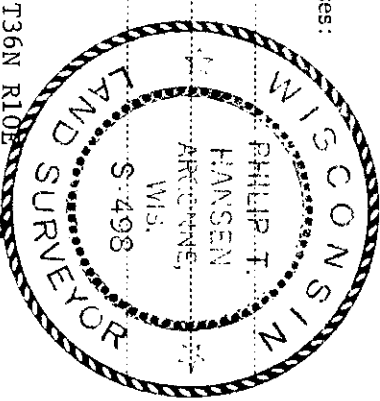

○ = Corner monument restored.

CERTIFIED LAND CORNER RESTORATION

Index No. A-16

History of original corner establishment:  
Original corner established by D.H. Vaughan, County Surveyor, in 1906 from which yellow pine 18" bears N32°E, 53 links and white pine 10" bears S12-1/2W, 45 links.  
Corner recovered by H.C. Lawrence, Registered Land Surveyor, in 1947. Corner re-established from stumps of Vaughan's old BT's. Set 3" cedar post. No new BT's.

Description of corner evidence found:

Recovered 3" cedar post, squared and scribed E-1/16 S3, E-1/16 S34 in poor condition.  
Also found old 2 x 4 cedar post, scribed S3 1/16, S34 E-1/16.

Recovered OBT's: Yellow pine stump N32°E(N35°E) 53 links  
Red pine stump 17" N82°W 47.6 links scribed E-1/16 BT.

Description of monument and accessories I established to perpetuate the original location of this corner.

Replaced wood post with 1-1/2" OD iron pipe w/brass cap stamped - S498

NBT: White birch 10" N42°E 64.6 links scribed 1/16 BT.

E-1/16 S|34  
S|3

T36N R10E  
CPT-1975

3710340010

Dated at Rhineland Wis., this 3rd day of July, 1975.

Signature Phillip T. Hansen Title Registered Land Surveyor Registration No. S-498  
(County Surveyor, Registered Land Surveyor, or other duly authorized official)

Office of Register of Deeds, County of Oneida  
Instrument was filed in this office for record on the 1st day of October, 1975  
at 3:00 o'clock P. M.

Lorne Verage Kuehn  
(Register of Deeds)

By Phillip T. Hansen Deputy