


CERTIFIED LAND CORNER RESTORATION

Index No. **A-15**


State of Wisconsin

County of Oneida } ss.

I, Phillip T. Hansen, do hereby certify that on the 10th day of May, 1975, I found evidence of the Quarter corner of between Sections 34 and 3 Township 37 and 36 North, Range 10 East, Fourth Principal Meridian, as described hereon; and that from this evidence I established a new monument and accessories as described hereon to perpetuate the original location of this corner.

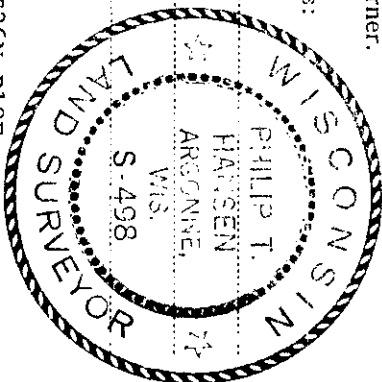

Resident witnesses:

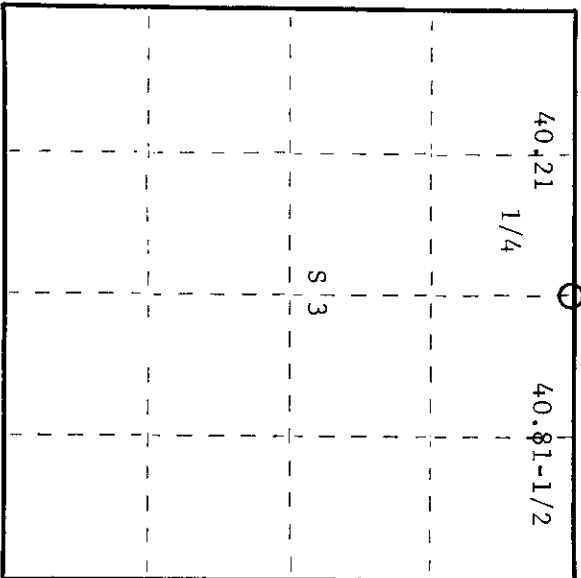

○ = Corner monument restored.

History of original corner establishment:

Original corner established by Hiram C. Fellows, Govt. Deputy Surveyor, in 1859 from which yellow pine 15" bears S70°E, 25 links and yellow pine 15" bears N15°W, 13 links. Corner recovered by D.H. Vaughan in 1906. He claims to have found the original government corner.

Corner recovered in 1946 by H.C. Lawrence, Registered Land Surveyor. He found a wooden corner post and iron pipe with brass cap. Recovered stumps of yellow pine. The N15°W stump showed evidence of scribe marks but the S70°E stump was too badly burned to determine scribe marks. Set 3" cedar post, squared and scribed.

Description of corner evidence found:

Recovered 3" cedar post, squared and scribed 1/4S S34, S3 in poor condition. Also an old squared post lying on the ground and a 2-1/2" iron pipe w/brass cap, but no scribing, stuck in the ground beside scribed post.

Recovered ORT's: Yellow pine 12" S33°W 49.2 links scribed BT
Yellow pine 12" stump S60°W 23 links scribed BT.

Description of monument and accessories I established to perpetuate the original location of this corner.
Replaced 3" cedar post with 2-1/2" IP w/brass cap stamped -

NBT: Yellow pine 6" S39°E 70.5 links scribed 1/4 BT.

S498
T37N
R
1/4 S/34 10
S/3 E

T36N
CPI-1975

3710340020

Dated at Rhineland, Wis., this 3rd day of July, 1975.

Signature Phillip T. Hansen Title Registered Land Surveyor Registration No. S-498
County Surveyor, Registered Land Surveyor, or other duly authorized official.

Office of Register of Deeds, County of Oneida at at day of October 1975
at 3:00 o'clock P. M.

Doris Verage Tuelke
(Register of Deeds)

By Doris Verage Tuelke Deputy