

CERTIFIED LAND CORNER RESTORATION

Index No. **A-14**

State of Wisconsin


County of Oneida } ss.

I Phillip T. Hansen 21st do hereby  
 certify that on the 19 75 day  
 of August 19 75, I found  
 evidence of the W-1/16 between  
 corner of Sections 3 and 34  
Township 36 and 37 North, Range  
10 East Fourth Principal Meridian,

as described hereon; and that from this evidence  
 I established a new monument and accessories  
 as described hereon to perpetuate the original  
 location of this corner.

Resident witnesses:

Glen Barker  
Jim Clafflin

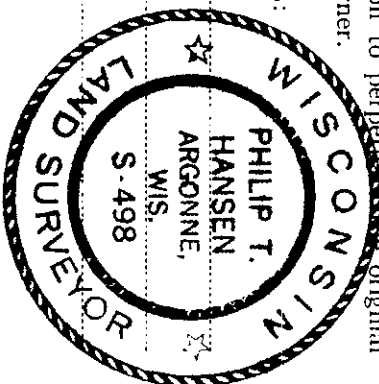

History of original corner establishment:  
 Corner established by D.H. Vaughan, County Surveyor, in 1906. Corner recovered by H.C. Lawrence, Registered Land Surveyor, in 1946. From the restored N-1/4 corner, he ran N88°35'W, a distance of 40.21 chains to a point 117 links north. Offsetting 58-1/2 links north of 20.10-1/2 chains, he found Vaughan's old W-1/16 corner post lying on the ground, and found the old post hole at 53 links north. Set new cedar post, but found no trees suitable for BT's. No trace was found of Vaughan's BT's.

Description of corner evidence found:

Recovered Lawrence's cedar post lying on ground, 6' from the post hole and point.  
 Recovered OBT's: Norway pine 10" N85°W 37.5 links-scribing partially grown over  
 Jack pine 10" S23°E 43 links-scribed S4 NBT

No record of above BT's in notes.

Description of monument and accessories I established to perpetuate the original location of this corner.


Replaced old point with 1-1/2" OD iron pipe w/2" brass cap stamped -

S498  
 T37N R10E

No additional accessories established.

S | 34  
 W-1/16 | S | 3

T36N R10E  
 CPI-1975

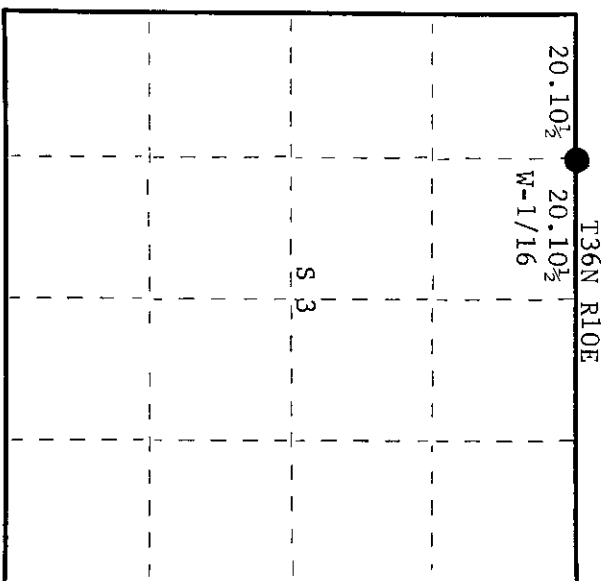

○ = Corner monument restored.

Dated at Rhineland, Wis., this 3rd day of September, 19 75.

Signature Phillip T. Hansen Title Registered Land Surveyor Registration No. S-498  
 (County Surveyor, Registered Land Surveyor, or other duly authorized official)

Office of Register of Deeds, County of Oneida  
 Instrument was filed in this office for record on the 14th day of October, 19 75  
 at 2:00 o'clock P. M.

Donis George Fuchs  
 (Register of Deeds)

By \_\_\_\_\_ Deputy

3710340030