

CERTIFIED LAND CORNER RESTORATION

Index No. **A 21**

State of Wisconsin



County of Oneida } ss.

I Phillip T. Hansen, do hereby certify that on the 21st day of August, 1975, I found evidence of the Section corner of Sections 35, 36, 2, and 1 Township 36 and 37, North, Range 10 East, Fourth Principal Meridian, as described hereon; and that from this evidence I established a new monument and accessories as described hereon to perpetuate the original location of this corner.

Resident witnesses:

Glen Barker

Jim Clarlin

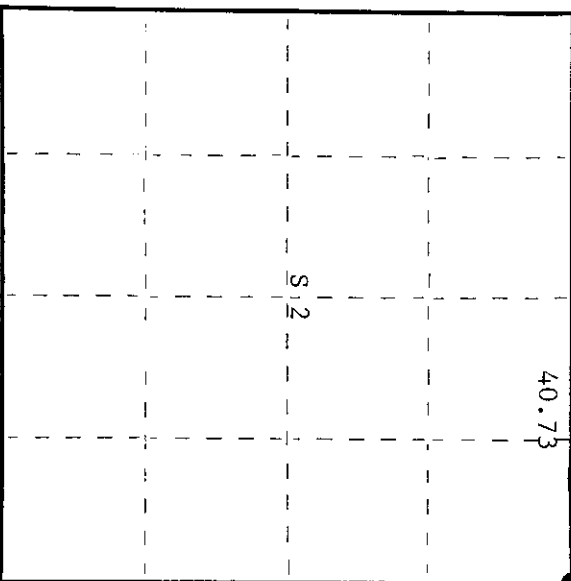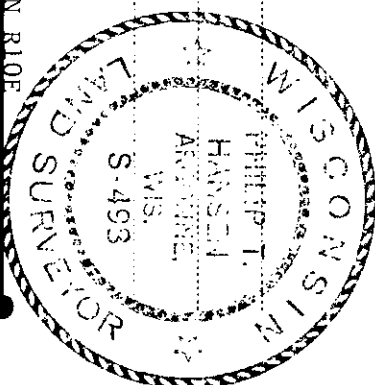

○ = Corner monument restored.

History of original corner establishment:

Original corner established by Hiram C. Fellows, Government Deputy Surveyor, in 1859 from which sugar 12" bears N9°E, 12 links; birch 6" bears S36°E, 2 links; birch 8" bears S79°W, 13 links; and white pine 12" bears N38°W, 40 links. Corner recovered and restored by D.H. Vaughan, County Surveyor, in 1906, who claims he set post from original BT's. Corner recovered and restored by H.C. Lawrence, Registered Land Surveyor, in 1949 during his retracement survey. Found old scribed post and stump of original BT: White pine 12" N38°W, 40 links. Also a galvanized iron pipe with brass cap not stamped. A collection of large loose boulders lying in depression bears N80°E, 50 links.

Description of corner evidence found:

Recovered the 2-1/2" iron pipe w/brass cap. Also an old decayed cedar post squared lying beside it.  
Recovered old white pine stump N38°W, 40 links now decayed. (Original BT.)

Description of monument and accessories I established to perpetuate the original location of this corner.  
As 2-1/2" iron pipe was in good shape, stamped the brass cap -

- NBT's: Elm 6" N75°E 66.6 links-scribed S.C. BT
- White birch 6" N32°W 40.8 links-scribed S.C. BT
- White birch 6" S27°W 47.2 links-scribed S.C. BT

S498  
T37N R10E  
T36N R10E  
CPI-1975

371035000

Dated at Rhinelander, Wis., this 10th day of September, 1975.

Signature Phillip T. Hansen Title Registered Land Surveyor Registration No. S-498  
(County Surveyor, Registered Land Surveyor, or other duly authorized official)

Office of Registrar of Deeds, County of Oneida  
at 12:00 o'clock P.M. day of November, 1975  
I hereby certify that the within instrument was filed in this office for record on the

Debra Marie Finkbeiner  
(Register of Deeds)

By: \_\_\_\_\_ Deputy