CERTIFIED LAND CORNER RESTORATION

Index No. Y-21

State of Wisconsin } ss.
County of Oneida

I Philip T. Hansen, do hereby certify that on the 22nd day of February, 1978, I found evidence of the S 1/16 corner of Sections 35 & 36 Township 37, North, Range 10 East, Fourth Principal Meridian, as described hereon; and that from this evidence I established a new monument and accessories as described hereon to perpetuate the original location of this corner.

Resident witnesses:

Glen Barker

Jim Claflin

Herb Wagoner

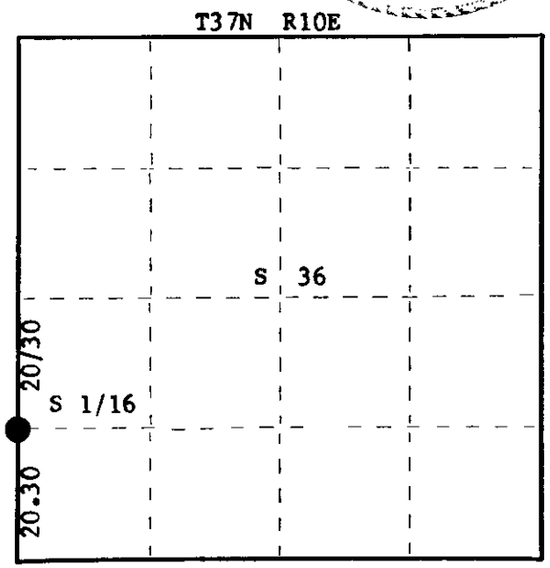

○ = Corner monument restored.

History of original corner establishment:

Corner established by D.H. Vaughan, Registered Land Surveyor, in 1906, from which white pine stump 24" bears S61½°E, 29½ links.

H.C. Lawrence, Registered Land Surveyor, recovered old post in 1949. Also found old BT, white pine stump 24" S61½°E, 29½ links.
Set new cedar post and made new BT's - Maple 6" S40°E, 37 links; aspen 8" N60°W, 23½ links.

Description of corner evidence found:

Recovered H.C. Lawrence's 6" cedar post, squared and scribed S 1/16, S35, S 1/16, S36, standing in poor condition.

Recovered OBT's (Vaughan's) white pine stump 24" S61½°E, 29½ links, scribe marks BT.
(H.C.Lawrence's) maple 6" (7") S40°E, 37 links (36.4 links), scribed S 1/16, S36 NBT.
Aspen 8" N60°W, 23½ links, now a rotted stump.

Description of monument and accessories I established to perpetuate the original location of this corner.

Replaced post with a 1½" o.d. iron pipe with 2" brass cap, stamped:
Projects 18" above ground.

NBT's - Maple 6" N78°E, 35.3 links
Maple 8" N6°E, 24.1 links
scribed 1/16 B.T.

S498
T37N R10E
S 1/16 35 + 36
CPI-1978

Dated at Rhinelander, Wis., this 7th day of March, 1978

Signature Philip T. Hansen Title Registered Land Surveyor Registration No. S-498
(County Surveyor, Registered Land Surveyor, or other duly authorized official)

Office of Register of Deeds, County of Oneida, I hereby certify that the within instrument was filed in this office for record on the 13th day of March, 1978 at 2:30 o'clock P M.

Doris Verage Kuehn
(Register of Deeds)

By ..... Deputy

FORM 985 H. C. MILLER CO., MILWAUKEE

3710351000