CERTIFIED LAND CORNER RESTORATION

Index No. X-21

State of Wisconsin } ss.
County of Oneida

I Philip T. Hansen, do hereby certify that on the 22nd day of February, 1978, I found evidence of the Quarter corner of Sections 35 & 36 Township 37, North, Range 10 East, Fourth Principal Meridian, as described hereon; and that from this evidence I established a new monument and accessories as described hereon to perpetuate the original location of this corner.

Resident witnesses:

Glen Barker

Jim Claflin

Herb Wagoner

WISCONSIN PHILIP T. HANSEN ARIZONA, WIS. S-498 LAND SURVEYOR

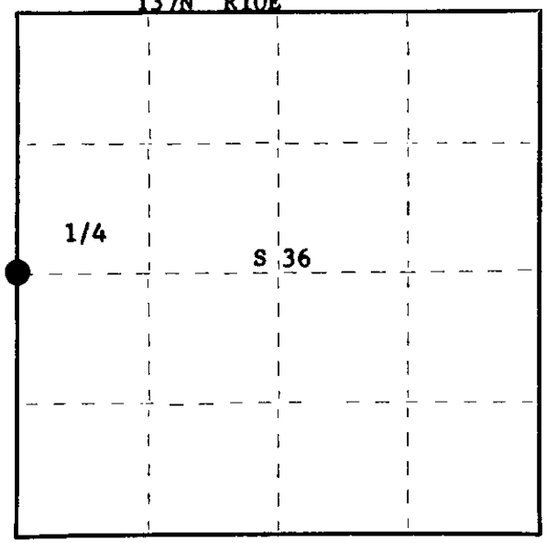

○ = Corner monument restored.

History of original corner establishment:

Original corner established by Wm. E. Dougherty, Deputy Surveyor, in 1859, from which Birch 10" bears S10°E, 12 links; Birch 8" N41°W, 46 links. Corner re-established by D.H. Vaughan in 1906 from which cedar 7" bears N79½°E, 31½ links; tamarack stump 15" bears S73°W, 35½ links.
Corner recovered by H.C. Lawrence, Registered Land Surveyor, in 1949. Recovered Vaughan's BT's - cedar 7" (dead) which bears N79½°E, 31½ links; tamarack 15" stump S73°W, 35½ links.
Set cedar post and made NBT's - Maple 7" N10°W, 21 links
Cedar 8" N68°E, 64 links

Description of corner evidence found:

Recovered Lawrence's 6" squared cedar post, scribed 1/4S S35, 1/4S S36, standing in poor condition.

Recovered old BT's - Maple 7" (9") N10°W (N4°W) 21 links, scribed 1/4S - Cedar 8" (10") N68°E, 64 links (63 links),(tree leaning) - scribed 1/4 S36

Description of monument and accessories I established to perpetuate the original location of this corner.

Replaced post with a 2½" Berntsen A-1 Federal Monument, cap stamped:
Projects 8" above ground.

NBT's - Maple 14" N70°W, 83.2 links
Maple 6" S37°E, 69.4 links
Scribed 1/4 BT.

S498
T37N
1/4 35 | 36
R10E
1978

Dated at Rhinelander, Wis., this 1st day of March, 1978

Signature Philip T. Hansen Title Registered Land Surveyor Registration No. S-498
(County Surveyor, Registered Land Surveyor, or other duly authorized official)

Office of Register of Deeds, County of Oneida, I hereby certify that the within instrument was filed in this office for record on the 13th day of March, 1978 at 2:30 o'clock P M.

Doris Verage Kuehn
(Register of Deeds)

By ..... Deputy

FORM 985 H. C. MILLER CO., MILWAUKEE

3710352000