

State of Wisconsin

County of Oneida } ss.

I Philip T. Hansen, do hereby certify that on the 2nd day of March, 1978, I found evidence of the Quarter corner of Sections 31 & 36 Township 37, North, Range 10 & 11 East, Fourth Principal Meridian,


as described hereon; and that from this evidence I established a new monument and accessories as described hereon to perpetuate the original location of this corner.

Resident witnesses:

Glen Barker

Jim Claffin

Herb Wagoner

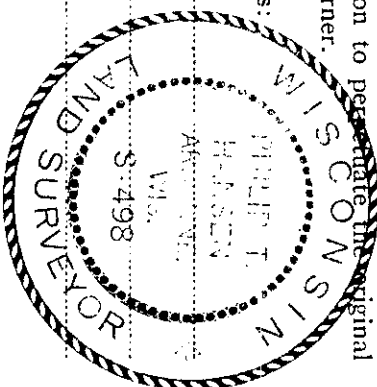

History of original corner establishment:
**Corner established by Hiram C. Fellows, Government deputy surveyor, in 1858, from which hemlock 16" bears S 26° E, 24 links; hemlock 16" N 82° W, 4 links.
Corner re-established by V. Maine, County Surveyor, in 1935. Set 2 1/2" iron pipe with brass cap and stamped.**


Description of corner evidence found:

Recovered Maine's 2 1/2" iron pipe with brass cap, stamped: Projects 24" above the ground.

**OBT - white pine stump 30" which bears S 64° E, 44.9 links
scribe mark 1 still visible
(have no records on corner)**

Description of monument and accessories I established to perpetuate the original location of this corner.
**Pipe is in excellent condition and securely set.
Painted blue and left in place.**

**NBT's - Sugar 7" N 40° E, 45.3 links
Maple 9" South 36.1 links
Maple 6" S 39° E, 30.4 links
Maple 8" N 63° W, 63.7 links
all scribed 1/4 BT.**

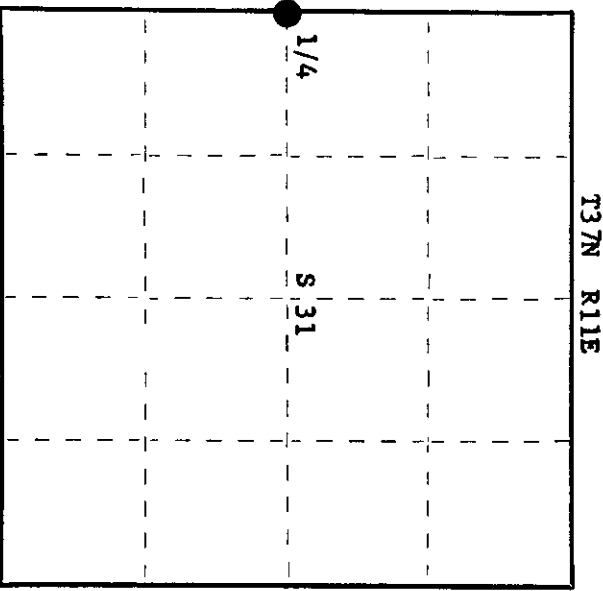

○ = Corner monument restored.

Dated at Rhinelander, Wis., this 30th day of March, 1978

Signature Philip T. Hansen Title Registered Land Surveyor Registration No. S-498
(County Surveyor, Registered Land Surveyor, or other duly authorized official)

Office of Register of Deeds, County of Oneida, I hereby certify that the within instrument was filed in this office for record on the 16th day of April, 1978 at 4:30 o'clock A. M.

Gene George Kuehn
(Register of Deeds)

By _____ Deputy