

State of Wisconsin

County of Oneida

ss.

I Phillip T. Hansen


do hereby certify that on the 18th day of January, 1978, I found evidence of the Section corner of S 1, 6, 7 & 12 Township 37 North, Range 11 & 12 East, Fourth Principal Meridian, as described hereon; and that from this evidence I established a new monument and accessories as described hereon to perpetuate the original location of this corner.

Resident witnesses:


Glen Barker

Jim Claflin

Herb Wagoner

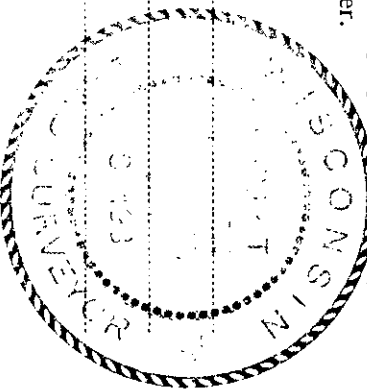

T37N R11E

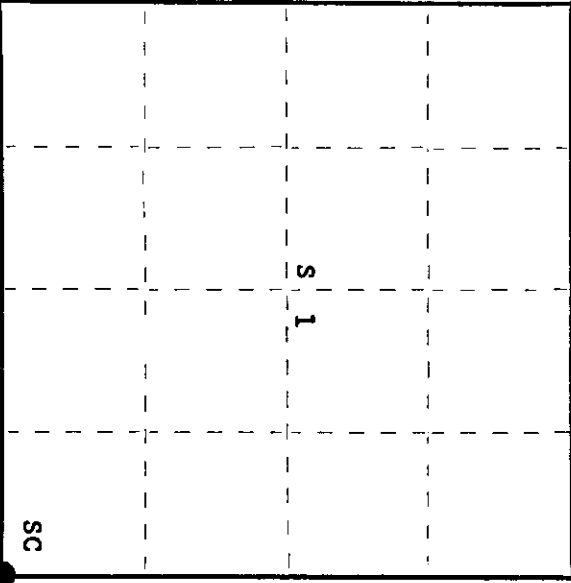

○ = Corner monument restored.

History of original corner establishment:

Original Corner established by Alfred Millard, Deputy Surveyor, in 1857, from which Sugar 12" bears N68°W, 30 links; Hemlock 20" bears N32°E, 32 links; Lind 20" bears S70°E, 25 links and Sugar 7" bears S25°W, 47 links.

Corner recovered by V.M. Maine, County Surveyor, in 1935. Claims to have recovered remains of old post and original BT, Sugar 12" N68°W, 30 links, still green. Scribe marks on facing. Also found stump of original basswood 20" S70°E, 25 links.

Marked NBT's - Yellow Birch 8" N25°W, 18 links

Sugar 16" N50°W, 36 links, Sugar 12" S35°W, 61 links.

Corner recovered by H.C. Lawrence, Registered Land Surveyor.

Description of corner evidence found:

Recovered 2 1/2" iron pipe with screw on brass cap, stamped:

Monument projects 18" above ground in very good condition.

Also recovered Lawrence's 4" cedar post, scribed S7, T37N S6, R12E,

Sec. 1 R11E, S12, standing beside it.

Recovered OBT's - Maine's Sugar 12" (16") S35°W (S42°W) 61 links, now a 10' stub.

Sugar 16" (20") N50°W (N47°W) 36 links (38 lks.), scribbling

rotted out.

Yellow Birch 8" (10") N25°W, 18 links, now a 20' stub,

scribbling rotted out.

R T37N
11 1+6 R
12 7 12 E
E

Description of monument and accessories I established to perpetuate the original location of this corner.

Left monument in place as recovered.

Marked NBT's - Sugar 6" S56°W, 15.7 links, scribed SC BT.

Maple 8" S28°E, 11.2 links, scribed SC BT.

Maple 7" N24°E, 21.2 links, scribed SC BT.

Sugar 7" N19°W, 36.1 links, scribed SC BT.

All distances made to iron pipe.

Dated at Rhineland, Wis., this 24th day of January, 1978

Signature Phillip T. Hansen Title Registered Land Surveyor Registration No. S-498
(County Surveyor, Registered Land Surveyor, or other duly authorized official)

Office of Register of Deeds, County of Oneida
Instrument was filed in this office for record on the 27th day of January, 1978
at 2:30 o'clock P. M.

Dorice Stange Kuhn
(Register of Deeds)

By: _____ Deputy

