

State of Wisconsin

County of **Oneida** } ss.

I **Phillip T. Hansen**, do hereby

certify that on the **18th** day

of **January**, 19**78**, I found

evidence of the **S 1/16**

corner of **Section 1 & 6**

Township **37**, North, Range

11 & 12, Fourth Principal Meridian,


as described hereon; and that from this evidence I established a new monument and accessories as described hereon to perpetuate the original location of this corner.

Resident witnesses:


Glen Barker

Jim Clafflin

Herb Wagoner

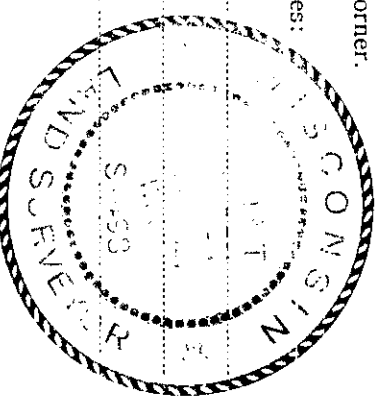

T37N R11E

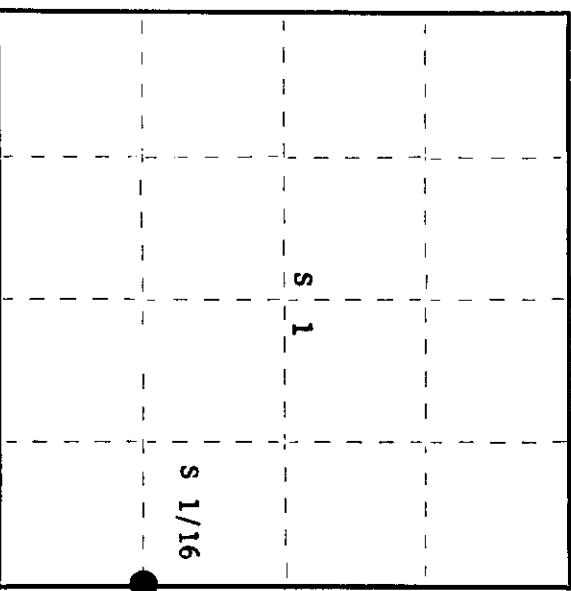

○ = Corner monument restored.

History of original corner establishment:

Corner established by V.M. Maine, County Surveyor, in 1935. Set corner at 19.97 north of SE corner.

Marked NBT's - Maple 14" N28°E, 39 links

Yellow Birch 30" N35°W, 51½ links

Description of corner evidence found:

Recovered 6" cedar post, squared and scribed 1/8 SM 1/8 SM, in very poor condition.

Recovered OBT's - Yellow Birch 30" (36") N35°W, 51.5 links, scribed 1/8S BT.

Maple 14" N28°E, 39 links, now a rotted stump.

Description of monument and accessories I established to perpetuate the original location of this corner.

Replaced post with 1½" iron pipe with 2" brass cap, stamped:

Monument projects 24" above ground.

Marked NBT's - Maple 6" N20°E, 50.6 links

Maple 6" S38°W, 25.4 links

Both scribed 1/16 BT.

S498
R T37N R
11 1 1/6 12
E S 1/16 E
1978

Dated at **Rhineland**, Wis., this **24th** day of **January**, 19**78**.

Signature *Phillip T. Hansen* Title **Registered Land Surveyor** Registration No. **S-498**
(County Surveyor, Registered Land Surveyor, or other duly authorized official)

Office of Register of Deeds, County of **Oneida** I hereby certify that the within

instrument was filed in this office for record on the **6th** day of **February**, 19**78**
at **9:30** o'clock **A.** M.

Dana George Kuehn
(Register of Deeds)

By: _____ Deputy

801101108