CERTIFIED LAND CORNER RESTORATION

Index No. C-17

State of Wisconsin } ss.
County of Oneida }

I Philip T. Hansen, do hereby certify that on the 24th day of January, 19 78, I found evidence of the Quarter corner of Section 2 & 3 Township 37, North, Range 11 East, Fourth Principal Meridian, as described hereon; and that from this evidence I established a new monument and accessories as described hereon to perpetuate the original location of this corner.

Resident witnesses:

Glen Barker

Jim Claflin

Herb Wagoner

WISCONSIN PHILIP T. HANSEN S-498 REGISTERED LAND SURVEYOR

T37N R11E

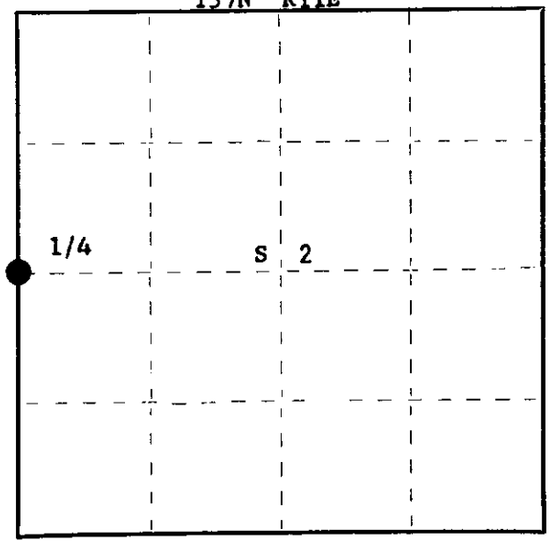

○ = Corner monument restored.

History of original corner establishment:

Original corner established by Wm. E. Dougherty, Deputy Surveyor, in 1859, from which Pine 12" bears S75°E, 100 links and Tamarack 10" bears S5°W, 20 links.

Corner recovered by J.J. Melendy in 1910. Set a 4 x 4 x 60" cedar post with stones around bottom. Pine stump 18" S65-3/4"E, 79 links.

Description of corner evidence found:

Recovered a 6" squared cedar post, scribed 1/4S S2, 1/4S S3, very old. When we removed this post from ice and muck, found Melendy's old cedar point and found some stones around it in the muck. Unable to recover remains of pine stump 18". No evidence under deep snow.

Description of monument and accessories I established to perpetuate the original location of this corner.

Set a 2½" Berntsen A-1 Federal Monument in the place of old point. Drove old point beside it and set cedar post beside the monument. Monument sets flush with ground. Set a 1½" x 4" iron pipe beside it for easy location. Cap stamped:

S498
T37N
1/4 S3 + S2
R11E
1978

No trees available and suitable for BT's, all thick alders.
Set four 1½" x 4' iron pipes for witness monuments, projecting 18"
#1 - North 35 links
#2 - East 25 links
#3 - S45°E, 14 links
#4 - S45°W, 20 links
Corner sets 86 links south of the south bank of Eagle Creek.

Dated at Rhinelander, Wis., this 27th day of January, 19 78.

Signature Philip T. Hansen Title Registered Land Surveyor Registration No. S-498
(County Surveyor, Registered Land Surveyor, or other duly authorized official)

Office of Register of Deeds, County of Oneida, I hereby certify that the within instrument was filed in this office for record on the 6th day of February, 19 78 at 9:30 o'clock a M.

Doris Verage Kuehn
(Register of Deeds)

By ..... Deputy

371032000

FORM 985 H C MILLER CO. MILWAUKEE