

CERTIFIED LAND CORNER RESTORATION

Index No. D-11

State of Wisconsin

County of Oneida } ss.

I Phillp T. Hansen, do hereby

certify that on the 12th day

of December, 1978, I found

evidence of the SC 1/16

corner of Section 4

Township 37, North, Range

11 East, Fourth Principal Meridian,

as described hereon; and that from this evidence

I established a new monument and accessories



as described hereon to perpetuate the original

location of this corner.

Resident witnesses:

Glen Barker

Jim Claflin

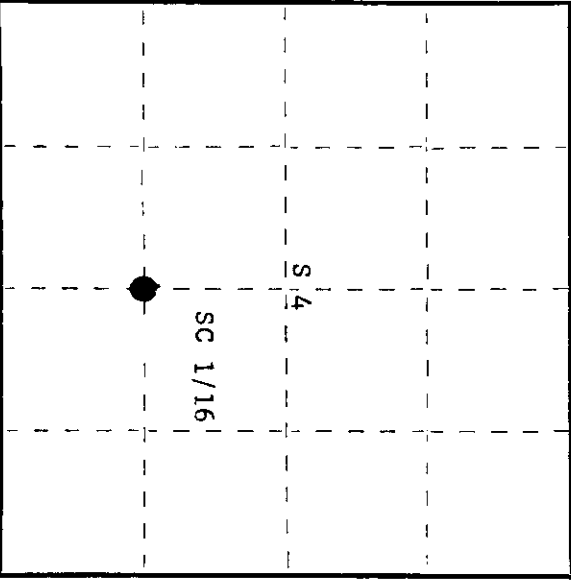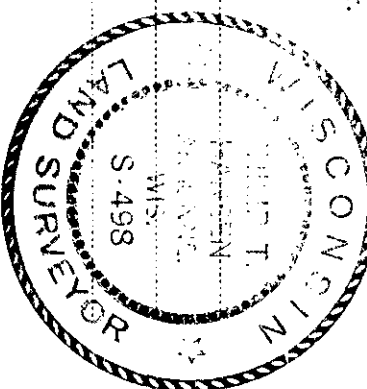

○ = Corner monument restored.

History of original corner establishment:
Corner established by Genisot Engineering surveyors.

Description of corner evidence found:

Recovered Genisot's 2" x 4' Iron pipe, projecting 24".

Recovered OBT's -
Hemlock 16" S12°W 53.7 feet, now a cut-off stump.
W. Birch 7" N10°W 42.68 feet, now a cut-off stump.

Description of monument and accessories I established to perpetuate the original location of this corner.

Replaced 2" pipe with 1 1/2" iron pipe with 2" brass cap, projecting 18" - cap stamped:

Marked NBT's -
Sugar 6" N48°W 9.55 feet, scribed 1/16 BT.
W. Birch 8" S14°E 33.34 feet, scribed 1/16 BT.

S498
T37N R11E
SC 1/16 S 4
CPI-1978

Dated at Rhineland, Wis., this 18th day of December, 1978.

Signature Phillp T. Hansen Title Registered Land Surveyor Registration No. S-498
(County Surveyor, Registered Land Surveyor, or other duly authorized official)

Office of Registrar of Deeds, County of Oneida
Instrument was filed in this office for record on the 25th day of January, 1979
at 1:15 o'clock P. M.

Deanne Tozage
(Registrar of Deeds)

By: _____ Deputy

3711041020