

CERTIFIED LAND CORNER RESTORATION



D 10 Index No. **D-10**

371104 1030

State of Wisconsin }
County of Oneida } ss.

I Philip T. Hansen, do hereby certify that on the 2nd day of May, 1975, I found evidence of the SW-1/16 corner of Section 4 Township 37 North, Range 11 East, Fourth Principal Meridian, as described hereon; and that from this evidence I established a new monument and accessories as described hereon to perpetuate the original location of this corner.

Resident witnesses:

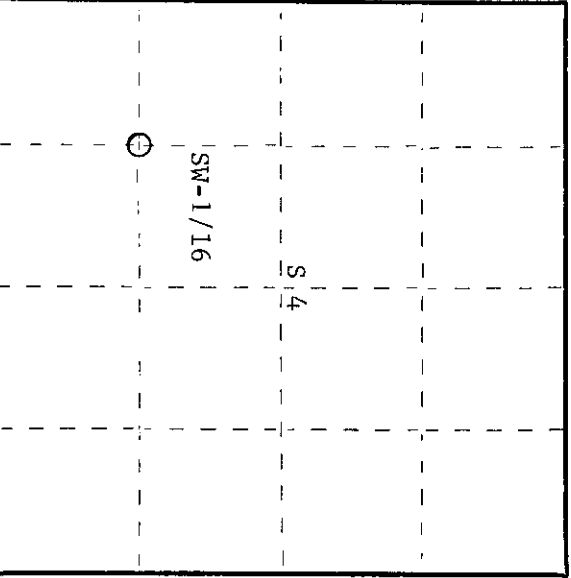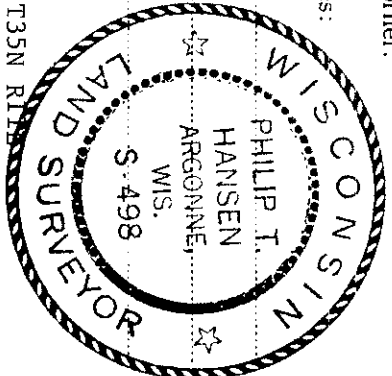

○ = Corner monument restored.

History of original corner establishment:

Corner established by H.C. Lawrence, Registered Land Surveyor. Set 4" cedar post, squared and scribed SW-1/16 S4, SW-1/16 S4.

Description of corner evidence found:

Recovered H.C. Lawrence's 4" cedar post in poor condition.
Recovered a 1-1/4" iron pipe projecting about 4" above a rock carron pile around the posts.
No old BT's were recovered.

Description of monument and accessories I established to perpetuate the original location of this corner.

Replaced old cedar post and 1-1/4" iron pipe with 1-1/2" OD iron pipe w/2" brass cap stamped -

Established NBT's: Sugar 12" N84°W 33.6 links scribed 1/16 BT
White birch 8" N4°E 31 links scribed 1/16 BT. SW-1/16 S4
T37N R11E S498
CPI-1975

Dated at Rhinelander Wis., this 1st day of July, 1975

Signature *Philip T. Hansen* Title Registered Land Surveyor Registration No. S-498
County Surveyor, Registered Land Surveyor, or other duly authorized official

Office of Register of Deeds, County of Oneida
instrument was filed in this office for record on the 1st day of October, 1975
at 3:00 o'clock P.M.

Doris Savage Tucker
(Register of Deeds)

By: Deputy