

CERTIFIED LAND CORNER RESTORATION


E 4 Index No. E.9

State of Wisconsin


County of Oneida } ss.

I Philip T. Hansen do hereby certify that on the 1st day of May 19 75 I found evidence of the Section corner of Sections 4, 5, 8, and 9 Township 37 North, Range 11 East, Fourth Principal Meridian, as described hereon; and that from this evidence I established a new monument and accessories as described hereon to perpetuate the original location of this corner.

Resident witnesses:

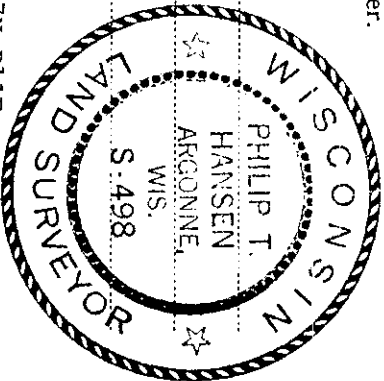

T37N R11E

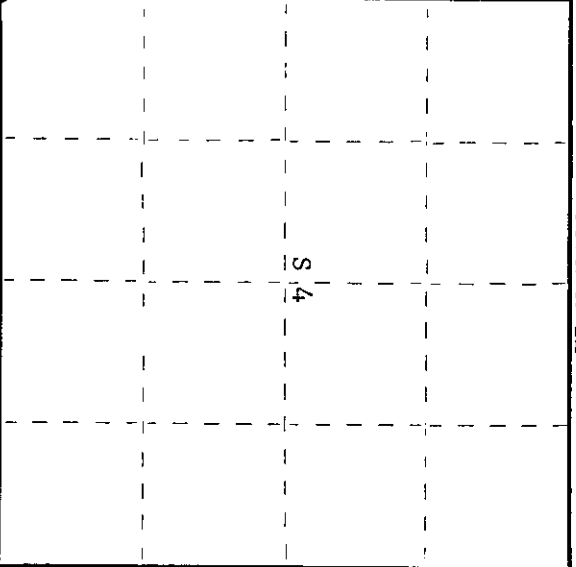

History of original corner establishment:

Original corner established by Wm. E. Dougherty, Govt. Deputy Surveyor, in 1859 from which tamarack 10" bears N18°E, 32 links and tamarack 9" bears S73°W, 25 links. Corner searched for by D.H. Vaughan, County Surveyor, in 1910 but could not recover the original corner. Set corner by proportion from northwest corner, Section 5, to the N-1/4 corner of Section 3 where he found the original B.T.'s. H.C. Lawrence, Registered Land Surveyor, during his retracement survey, recovered Vaughan's corner but did not agree with his computations. The measurements were not retaken. V.M. Maine, County Surveyor, remarked this corner, set a 2-1/2" iron pipe with brass cap.

Description of corner evidence found:

Recovered a 6" cedar post, squared and scribed S4, S5, S8, S9. Also a 3" squared post projecting about 18" above ground level. Also a 2-1/2" iron pipe w/brass cap stamped -

S5 | S4
S8 | S9

Recovered Hem 12"(13) BT S56°W (S52°W).
Iron pipe 53 links scribed S8 BT.

S5 | S4
S8 | S9

Cedar 6"(10") N25°E (N30°E)
Post 73 links -

I.P. 73.4 links - scribed S4 SBT
Description of monument and accessories I established to perpetuate the original location of this corner.

No additional accessories established iron pipe and old post painted blue.

When time permits, these lines will be rerun to check the position of corners established by D.H. Vaughan.

Dated at Rhinelander, Wis. this 25th day of June, 1975.

Signature: *Philip T. Hansen* Title: Registered Land Surveyor Registration No. S-498
(County Surveyor, Registered Land Surveyor, or other duly authorized official)

Office of Registrar of Deeds, County of Oneida
Instrument was filed in this office for record on the 1st day of October, 1975 at 3:00 o'clock P.M.

Donna Savage Fuchs
(Registrar of Deeds)

By: Deputy

3711050000

2000 - Recovered 2 1/2" iron pipe-brass cap monument set by Maine at this corner position. Hemlock and Cedar B.T.'s listed by Hanson also recovered. Made new B.T.'s and accessories to bring monumentation to County standards.

REGISTER OF DEEDS OFFICE
ONEIDA COUNTY, WIS.
FILED
MAY 18 2000
At _____ O'Clock _____ M
THOMAS H. LEIGHTON
REGISTER OF DEEDS