

CERTIFIED LAND CORNER RESTORATION

Index No. **E-8**



State of Wisconsin

County of **Oneida**

ss.

I **Phillip T. Hansen**, do hereby certify that on the **3rd** day of **February**, 19 **78**, I found evidence of the **E 1/16** corner of **Sections 5, 6, 8** Township **37** North, Range **11 East**, Fourth Principal Meridian, as described hereon; and that from this evidence I established a new monument and accessories as described hereon to perpetuate the original location of this corner.

Resident witnesses:
Glen Barker
Jim Claffin

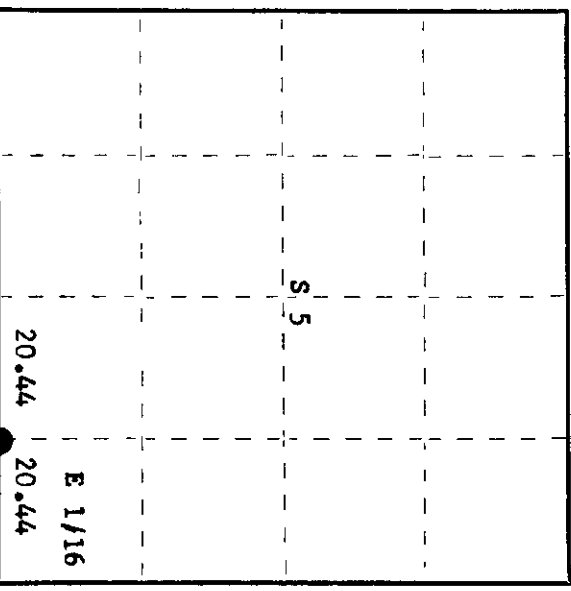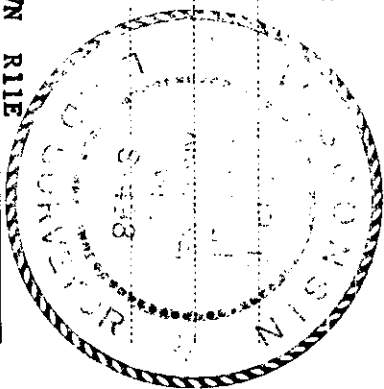

History of original corner establishment:

Corner of unknown origin recovered by H.C. Lawrence, Registered Land Surveyor, in 1949. Ran line east from recovered 1/4 corner to E 1/16 corner distance of 20.47 chains, continued east and at 20.41 closed out at section corner. Reset E 1/16 at 20.44 chains intermediate. Set post and marked dead tamarack 8" N70 1/2° E, 27 links and White Pine 18" S56° E, 126 links.

Description of corner evidence found:

Recovered 4" cedar post, squared and scribed E 1/16 S5, E 1/16 S8, standing but in poor condition.
 Recovered OBT's - Tamarack 8" (dead) N70 1/2° E, 27 links, scribed E 1/16 S5 NBT.
 White Pine 18" (20") S56° E (S57° E) 126 links, scribed E 1/16 S8.

Description of monument and accessories I established to perpetuate the original location of this corner.

Replaced post with 1 1/2" iron pipe with 2" brass cap, stamped:
 Marked NBT - Tamarack 6" S12° W, 27.7 links, scribed 1/16 BT.
 Monument projects 12" above ground.
 Set 6' picket beside monument.

S498
 T37N R11E
 E 1/16 S 1/5
 ST 8
 CPI-1978

Dated at **Rhinelander**, Wis., this **7th** day of **February**, 19 **78**.

Signature **Phillip T. Hansen**, Title **Registered Land Surveyor**, Registration No. **S-498**
 (County Surveyor, Registered Land Surveyor, or other duly authorized official)

Office of Registrar of Deeds, County of **Oneida**, I hereby certify that the within instrument was filed in this office for record on the **8th** day of **February**, 19 **78** at **2:45** o'clock **P.** M.

Donna Leaga Kuder
 (Registrar of Deeds)

By: _____ Deputy

00050112M