



CERTIFIED LAND CORNER RESTORATION

Index No. **E-7**

State of Wisconsin } ss.  
 County of Oneida

I Phillip T. Hansen, do hereby certify that on the 6th day of February, 1978, I found evidence of the Quarter corner of Sections 5 & 8 Township 37, North, Range 11 East, Fourth Principal Meridian, as described hereon; and that from this evidence I established a new monument and accessories as described hereon to perpetuate the original location of this corner.

Resident witnesses:  
Glen Barker  
Jim Claffin

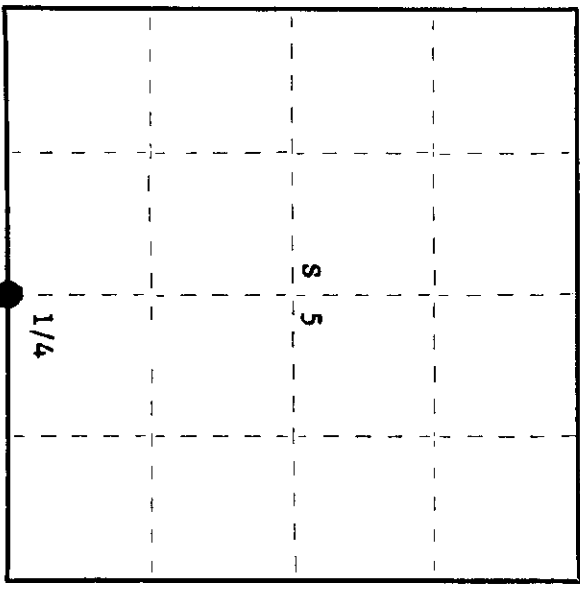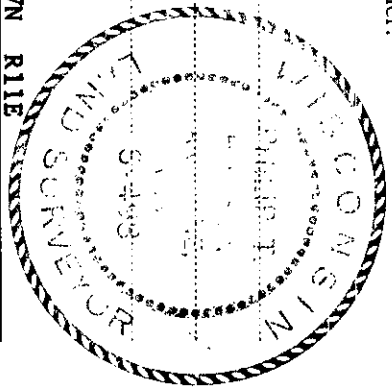

○ = Corner monument restored.

History of original corner establishment: Original corner established by Wm. E. Dougherty, Deputy Surveyor, in 1859, from which spruce 6" bears N69°W, 12 links and spruce 8" bears S35°W, 17 links.  
 Corner recovered by H.C. Lawrence, Registered Land Surveyor, in 1949. From recovered 1/16 corner between Sections 5 & 8 he ran a random line west 20.41 chains to close out 20 links south of 1/4 corner, an old cedar post in position.  
 Set new cedar post and marked NBT's - Hemlock 14" S45°W, 16 links and Yellow Birch 16" N64°W, 31 links.

Description of corner evidence found:  
 Recovered 6" cedar post, squared and scribed 1/4S S5, 1/4S S8, standing in poor condition. Also found a piece of old stake beside it.  
 Recovered OBT's - Hemlock 14" (16") S45°W (S48°W) 16 links (15.4 links). Tree is leaning to north scribed 1/4 S8 NBT.  
 Yellow Birch 16" (18") N64°W, 31 links, scribed 1/4S S5 NBT.

Description of monument and accessories I established to perpetuate the original location of this corner.  
 Replaced cedar post with 2 1/2" Bernitsen A-1 Federal Monument (O.C.) projecting 8" above ground. Cap stamped:  
 Marked NBT's - Cedar 7" N33°E, 41 links S498  
 Hemlock 9" S86°E, 46.4 links T37N  
 Maple 6" S9°E, 28.4 links, all scribed 1/4 BT. S 15  
 Set a cedar post beside it for easy identification. 1/4 S 18  
 Corner sets on the south end of balsam and cedar swamp. R11E  
 Ridge of big hemlocks to the south. 1978

Dated at Rhinelander, Wis., this 7th day of February, 1978

Signature Phillip T. Hansen Title Registered Land Surveyor Registration No. S-498  
 (County Surveyor, Registered Land Surveyor, or other duly authorized official)

Office of Register of Deeds, County of Oneida  
 Instrument was filed in this office for record on the 8th day of February, 1978  
 at 2:45 o'clock P. M.

Danae Neaghe Kuehn  
 (Register of Deeds)

By \_\_\_\_\_ Deputy

3711050020