

CERTIFIED LAND CORNER RESTORATION

Index No. D-8

History of original corner establishment:

No records of any previous survey.

State of Wisconsin

County of Oneida } ss.

I, Phillip T. Hansen, do hereby certify that on the 25th day of January, 1980, I found ~~restored~~ the SE 1/16 corner of Section 5



Township 37, North, Range 11 East, Fourth Principal Meridian, as described hereon; and that from this evidence I established a new monument and accessories as described hereon to perpetuate the original location of this corner.

Resident witnesses:

Glen Barker

Jim Claflin

Herb Wagoner

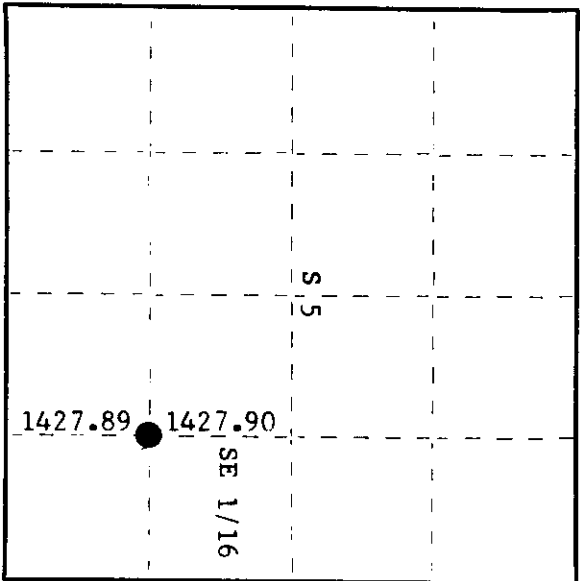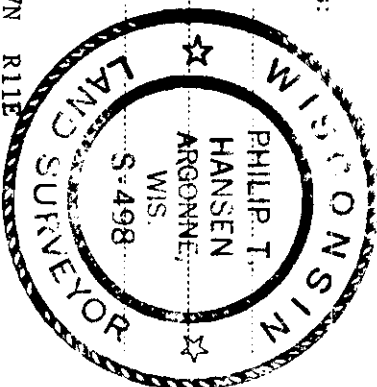

○ = Corner monument restored.

Description of corner evidence found:

No evidence of any corner recovered.

Corner established by traverse and computation.

Computed distance from E 1/16 between section 5 and 8 to EC 1/16 is 2855.79 feet at bearing N 6° 02' 58" W.

Computed location of SE 1/16 is 1427.89 feet from E 1/16 and 1427.90 feet from EC 1/16.

Description of monument and accessories I established to perpetuate the original location of this corner.

Set a 1-1/2" iron pipe with 2" brass cap, stamped:

Monument projects 16".

Marked NBT's - Cedar 8" S89°W 8.05 feet

Cedar 8" N23°E 6.05 feet

both scribed 1/16 BT.

S498  
T37N R11E  
SE 1/16 S+5  
CPI-1980

Dated at Rhinelander, Wis., this 28th day of January, 1980.

Signature: *Phillip T. Hansen* Title: Registered Land Surveyor Registration No. S-498  
County Surveyor, Registered Land Surveyor, or other duly authorized official)

Office of Register of Deeds, County of Oneida. I hereby certify that the within instrument was filed in this office for record on the 11th day of February, 1980 at 2:15 o'clock P.M.

*Toni George Fisher*  
(Register of Deeds)

By: Deputy

0101501010