



State of Wisconsin

County of Oneida } ss.

I, Phillip T. Hansen, do hereby certify that on the 22nd day of January, 1980, I found ~~corner of the~~ SC 1/16 corner of Section 5 Township 37 North, Range 11 East, Fourth Principal Meridian, as described hereon; and that from this evidence I established a new monument and accessories as described hereon to perpetuate the original location of this corner.

Resident witnesses:

Glen Barker  
Jim Claflin  
Herb Wagoner

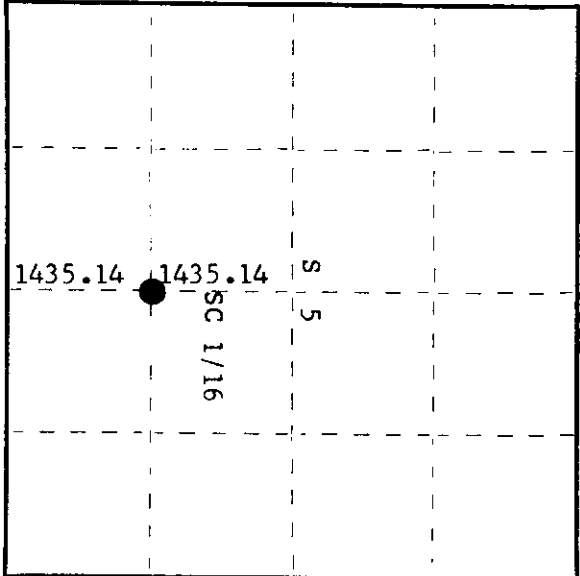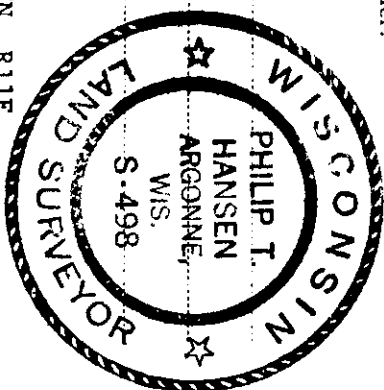

○ = Corner monument restored.

CERTIFIED LAND CORNER RESTORATION

Index No. D-7

History of original corner establishment:  
No records of any previous survey.

Description of corner evidence found:  
No evidence of any corner recovered.  
Corner established by traverse and computation.  
Ran traverse from N 1/4 to S 1/4 and from W 1/4 to E 1/4 to establish the C 1/4 corner.  
Computed distance from C 1/4 to S 1/4 is 2870.29 feet at bearing S 6° 17' 19" E.  
Set SC 1/16 at 1435.14 feet intermediate.

Description of monument and accessories I established to perpetuate the original location of this corner.  
Set a 1-1/2" iron pipe with 2" brass cap, stamped: S498  
Monument projects 12" above ground. T37N R11E  
Marked NBT's - Cedar 7" S29°W 8.08 feet  
Cedar 7" S84°E 17.95 feet  
both scribed 1/16 BT SC 1/16 S+5  
CPI-1980

Dated at Rhineland, Wis. this 28th day of January, 1980.

Signature: *Phillip T. Hansen* Title: Registered Land Surveyor Registration No. S-498  
(County Surveyor, Registered Land Surveyor, or other duly authorized official)

Office of Register of Deeds, County of Oneida  
Instrument was filed in this office for record on the 11th day of February, 1980  
at 2:15 o'clock P.M.

*Doris Vernege Kuehn*  
(Register of Deeds)

By: Deputy

3711051020