



CERTIFIED LAND CORNER RESTORATION

Index No. C-7

State of Wisconsin }
County of Oneida } ss.

I Phillip T. Hansen, do hereby certify that on the 16th day of January, 1980, I ~~found~~ established the C 1/4 corner of Section 5 Township 37, North, Range 11 East, Fourth Principal Meridian, as described hereon; and that from this evidence I established a new monument and accessories as described hereon to perpetuate the original location of this corner.

Resident witnesses:
Glen Barker
Herb Wagoner
Jim Clafflin

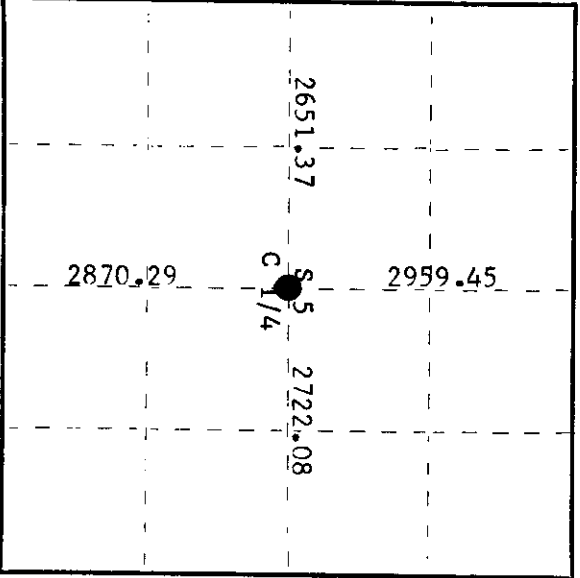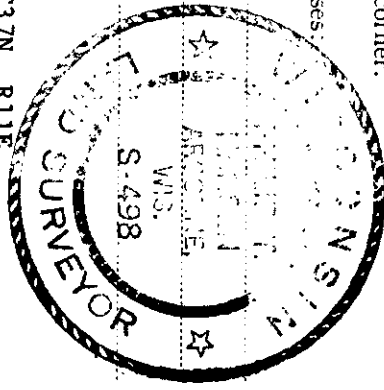

○ = Corner monument restored.

History of original corner establishment:

No records of any previous survey.

Description of corner evidence found:

No evidence of any corner recovered. Corner established by traverse and computation. Ran traverse around section to compute the 1/4 corners. Traversed from S 1/4 to N 1/4 and W 1/4 to E 1/4 corner to establish C 1/4.

Description of monument and accessories I established to perpetuate the original location of this corner. Set a 2-1/2" Bernitsen A-1 Federal Monument for C 1/4 corner. Cap stamped: Monument projects 16".

Marked NBT's - Cedar 8" N41°W 49.15 feet
Cedar 5" S87°W 38.50 feet
scribed C 1/4 BT.
No other trees suitable for BT's.

T37N R11E
C 1/4 S+5
S498 - 1980

Dated at Rhineland, Wis., this 28th day of January, 19 80.

Signature: Phillip T. Hansen Title: Registered Land Surveyor Registration No. S-498
(County Surveyor, Registered Land Surveyor, or other duly authorized official)

Office of Register of Deeds, County of Oneida
Instrument was filed in this office for record on the 10th day of March, 1980
at 9:10 o'clock A. M. I hereby certify that the within

By: Doris Leage Kuhn Deputy
(Register of Deeds)