

CERTIFIED LAND CORNER RESTORATION

Index No. B-7



State of Wisconsin

County of Oneida } ss.

History of original corner establishment:
No records of any previous survey.

I, Phillip T. Hansen, do hereby certify that on the 29th day of January, 1980, I ~~found~~ established the NC 1/16 corner of Section 5 Township 37 North, Range 11 East, Fourth Principal Meridian, as described hereon; and that from this evidence I established a new monument and accessories as described hereon to perpetuate the original location of this corner.

Resident witnesses:
Glen Barker
Jim Clafflin
Herb Wagoner

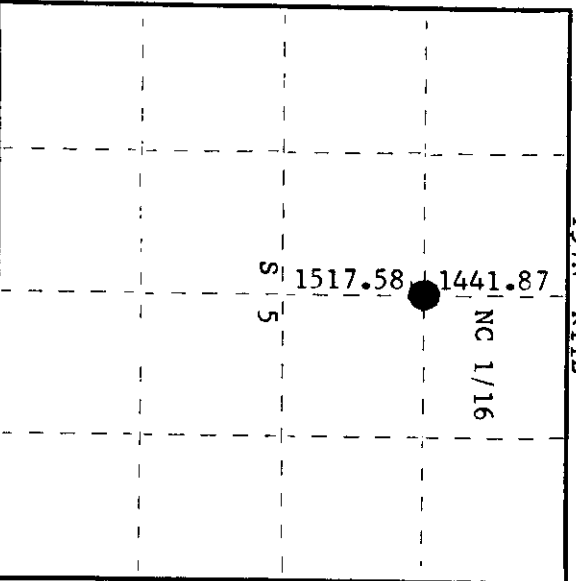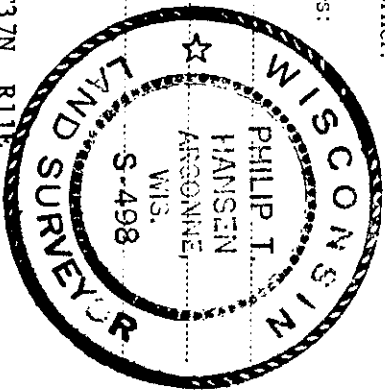

○ = Corner monument restored.

Description of corner evidence found:

No evidence of any corner recovered.

Corner established by traverse and computation. Computed distance from N 1/4 of section 5 to the C 1/4 corner is 2959.45 feet at bearing S 6° 17' 19" E. Computed location of NC 1/16 corner is S 6° 17' 19" E, 1441.87 feet of N 1/4 and N 6° 17' 19" W, 1517.58 feet from C 1/4 corner.

Description of monument and accessories I established to perpetuate the original location of this corner.

Set a 1-1/2" iron pipe with 2" brass cap, projecting 12", stamped:

Marked NBT's -
B. Spruce 5" N52°E 29.9 feet S498
B. Spruce 5" S21°E 20.00 feet T37N R11E
both scribed 1/16 BT. NC 1/16 S-5
CPI-1980

Dated at Rhineland, Wis., this 25th day of February, 1980.

Signature: Phillip T. Hansen Title: Registered Land Surveyor Registration No. S-498
(County Surveyor, Registered Land Surveyor, or other duly authorized official)

Office of Register of Deeds, County of Oneida 10th day of March, 1980
at 9:10 o'clock A.M. I hereby certify that the within instrument was filed in this office for record on the 10th day of March, 1980

By: Doris Leverage Kuehn
(Register of Deeds)

By: _____ Deputy