

CERTIFIED LAND CORNER RESTORATION



Index No. B-6

State of Wisconsin

County of Oneida } ss.

I Phillip T. Hansen, do hereby certify that on the 29th day of January, 1980, I ~~found~~ restored the NW 1/16 corner of Section 5 Township 37, North, Range 11 East, Fourth Principal Meridian, as described hereon; and that from this evidence I established a new monument and accessories as described hereon to perpetuate the original location of this corner.

Resident witnesses:
Glen Barker
Jim Clafin
Herb Wagoner

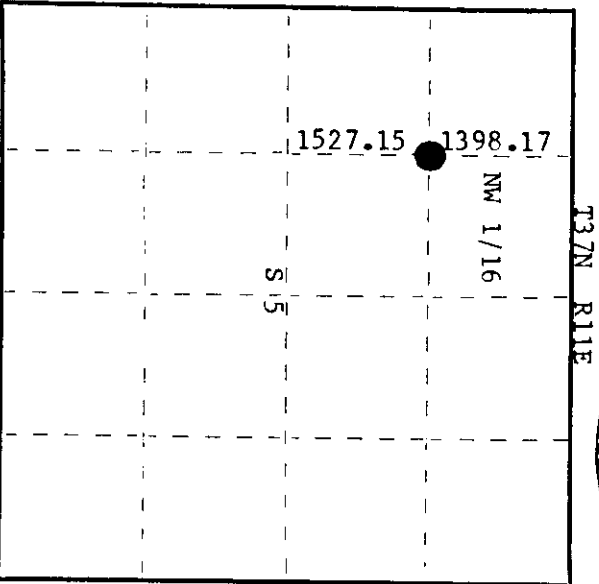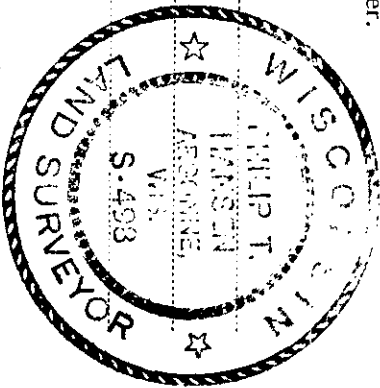

○ = Corner monument restored.

History of original corner establishment:
No records of any previous survey.

Description of corner evidence found:

No evidence of any corner recovered.

Corner established by traverse and computation. Computed distance from W 1/16 between sections 5 and 32 to WC 1/16 section 5 is 2925.16 feet at bearing S 6° 10' 29" E. Computed location of NW 1/16 is 1398.27' from W 1/16 corner and 1527.15' from WC 1/16 corner.

Description of monument and accessories I established to perpetuate the original location of this corner.

Set a 1-1/2" iron pipe with 2" brass cap, projecting 12", stamped:

Marked NBT's -
Tamarack 8" N49°W 7.85 feet S498
Tamarack 9" S51°W 16.98 feet T37N R11E
both scribed 1/16 BT. NW 1/16 S+5
CPI-1980

Dated at Rhineland, Wis., this 25th day of February, 1980

Signature: Phillip T. Hansen Title: Registered Land Surveyor Registration No. S-498
(County Surveyor, Registered Land Surveyor, or other duly authorized official)

Office of Register of Deeds, County of Oneida, I hereby certify that the within instrument was filed in this office for record on the 10th day of March, 1980 at 9:10 o'clock A. M.

Dennis George Kuehn
(Register of Deeds)

By: _____ Deputy