


CERTIFIED LAND CORNER RESTORATION

E 5 Index No. E-5


3711060000

State of Wisconsin }
County of Oneida } ss.

I Philip T. Hansen do hereby certify that on the 2nd day of May 19 75, I found evidence of the Section Corner of Sections 5, 6, 7, and 8 Township 37 North, Range 11, East, Fourth Principal Meridian, as described hereon; and that from this evidence I established a new monument and accessories as described hereon to perpetuate the original location of this corner.

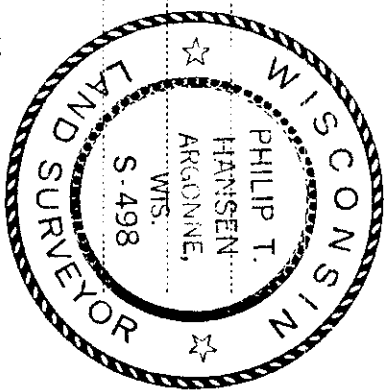

Resident witnesses.

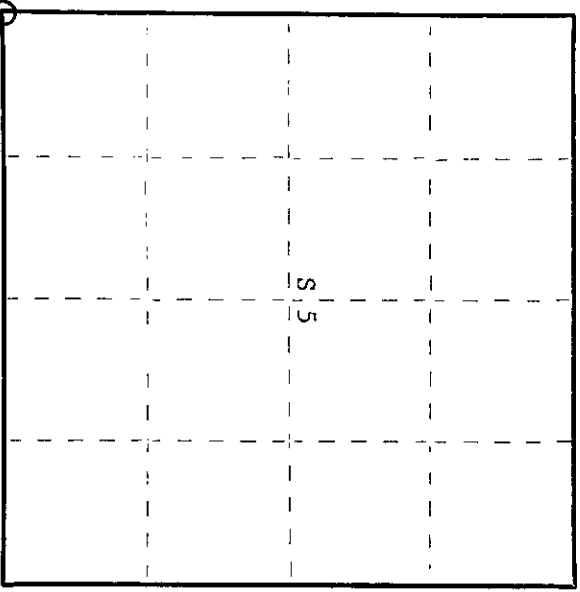

○ = Corner monument restored.

History of original corner establishment

Original corner established by Wm. E. Dougherty, Govt. Deputy Surveyor, in 1859 from which sugar 18" bears S60°E, 12 links and hemlock 7" bears N32°W, 18 links.

Corner recovered by V.M. Maine, County Surveyor. Set 2-1/2" iron pipe w/brass cap, scribed S5, S6, S7, and S8.

Corner recovered by H.C. Lawrence, Registered Land Surveyor, in 1949. Established a basswood 14", S22°E, 131 links. This was not scribed.

Description of corner evidence found:

Recovered Maine's 2-1/2" iron pipe w/brass cap, stamped S5, S6, S7, and S8 on edge of dirt road. A 1/2" x 6" x 4" angle iron was set next to it. The pipes had been bent over.

OBT: Basswood 14" (16) S22°E 131 links not scribed.

Description of monument and accessories I established to perpetuate the original location of this corner.

Set 2-1/2" iron pipe w/brass cap stamped as witness corner as the corner stake sets on edge of road and is in danger of being knocked out -

NBT's: White birch 12" S50°E 59 links S498
White birch 10" N22°E 106 links scribed SC BT. WC S6/S5 S7/S8
T37N R11E

CPI-1975
N50°E, 45 links

Dated at Rhinelander, Wis., this 1st day of July, 19 75.

Signature *Philip T. Hansen* Title Registered Land Surveyor Registration No. S-498
County Surveyor, Registered Land Surveyor, or other duly authorized official

Office of Register of Deeds, County of Oneida
Instrument was filed in this office for record on the 1st day of October 19 75
at 3:00 o'clock P.M.

Doris Tenney Kuehn
(Register of Deeds)

By: Deputy