

CERTIFIED LAND CORNER RESTORATION

Index No. **E-3**


State of Wisconsin }
 County of Oneida } ss.

I Philip T. Hansen, do hereby certify that on the 9th day of September, 1976, I found evidence of the quarter corner of section 37 and 7 Township 37 North, Range 11 East, Fourth Principal Meridian, as described hereon; and that from this evidence I established a new monument and accessories as described hereon to perpetuate the original location of this corner.

Resident witnesses:

Glen Barker
 Jim Staffin
 Herb Masoner

T37N 11E

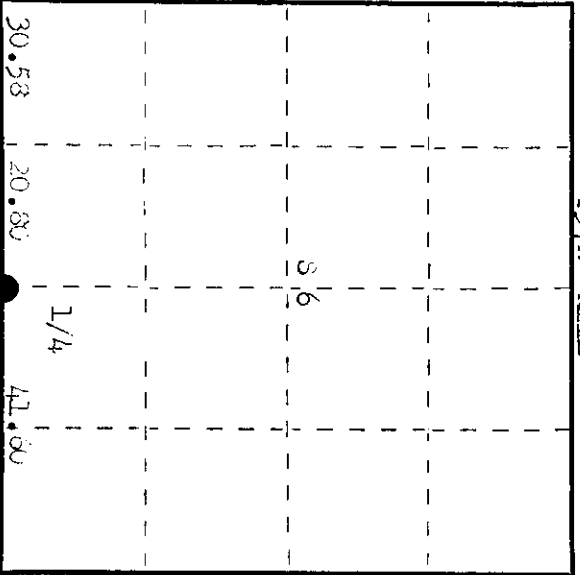

O = Corner monument restored.

History of original corner establishment:

Original corner established by J. M. W. Jorgensen, Deputy Surveyor, in 1859, from which Tamarack 8" bears S 17° W 25 Links and Tamarack 8" bears N 61° W 37 Links. Corner re-established by H. C. Lawrence, registered Land Surveyor, in 1960, ran a random line N 87° W from Section Corner 5-6, 7, 8 a distance of 93.00 chains to intersect range line 3.36 chains north of section corner. Set 1/4 corner at 41.60 chains and 150 links south. Marked corner with cedar post. No record of 8" links established.

Description of corner evidence found:

Recovered 4" cedar post squared and scribed 1/4 36, 1/4 37 in fair condition. No evidence of any 8" links.

Description of monument and accessories I established to perpetuate the original location of this corner.

Replaced 4" cedar post with 2 1/2" diameter x 1" Federal L monument (aluminum with magnet in cap and base). Projecting 1 1/2" above ground. Cap scribed: Drove support stakes in beside monument.
 8" links - black spruce 4" x 200" = 28.2 links, scribed 1/4 36.
 8" links - black spruce 4" x 71" = 28 links, scribed 1/4 37.
 8" links - black spruce 5" x 52" = 31.9 links, scribed 1/4 37.
 Monument and 8" links painted blue.

T37N 11E

1/4 36
 1/4 37
 3498-1976

Dated at Oneida, Wis., this 20th day of September, 1976.

Signature *Philip T. Hansen* Title Registered Land Surveyor Registration No. 2-428
 (County Surveyor, Registered Land Surveyor, or other duly authorized official)

Office of Register of Deeds, County of Oneida
 at 10:30 o'clock 9th day of September, 1976
 I hereby certify that the within instrument was filed in this office for record on the 9th day of September, 1976

Louise Berger Fackler
 (Register of Deeds)

By _____ Deputy

3711 06 0020