CERTIFIED LAND CORNER RESTORATION

Index No. D-2

State of Wisconsin
County of Oneida } ss.

I Philip T. Hansen, do hereby certify that on the 9th day of September, 1976, I found evidence of the S. 1/16 corner of Section 6 Township 37, North, Range 11 East, Fourth Principal Meridian, as described hereon; and that from this evidence I established a new monument and accessories as described hereon to perpetuate the original location of this corner.

Resident witnesses.

Glen Barker

Jim Claflin

Herb Wagoner

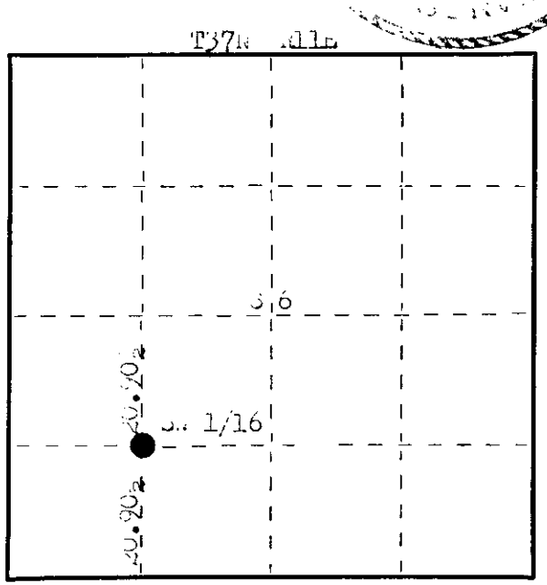

○ = Corner monument restored.

History of original corner establishment:

Corner established by H.J. Lawrence, Registered Land Surveyor, in 1900. On the random line north from a 1/16 corner, between sections 6 and 7 - 41.81 chains. Set S. 1/4 at 20.90 chains. Set cedar post and marked BTs - white pine 10" S 70° W 30 links and aspen 9" W 15° S 4½ links.

Description of corner evidence found:

Recovered 4" cedar post, squared and scribed S. 1/16 S6, S. 1/16 S6, in fair condition.

Recovered BTs - white pine 10" (11") S 70° W (S 76° W) 30 links, scribed S6 BT.
Aspen 9" W 15° W 4.5 links, scribed S. 1/16 BT, now a 30" stub.

Description of monument and accessories I established to perpetuate the original location of this corner.

Replaced 4" cedar post with 3/4" iron pipe with 2" brass cap stamped:
Monument projects 24" above ground.
NBT - white spruce 10" S 20° W 49.2 links.
Lawrence did not run the W 1/4 of this S. 1/4 to establish the S. 1/16 corner. It was set equidistance between the W 1/16 and the WC 1/16 corner.

S496
T37N R11E
S. 1/16 S 6
SEP-1976

Dated at Rhinelander, Wis., this 20th day of September, 1976

Signature Philip T. Hansen Title Registered Land Surveyor Registration No. S-478
(County Surveyor, Registered Land Surveyor, or other duly authorized official)

Office of Register of Deeds, County of Oneida I hereby certify that the within instrument was filed in this office for record on the 9th day of November, 1976 at 10:30 o'clock a M.

Doris Lerage Kuenn
(Register of Deeds)

By ..... Deputy

FORM 985 H. C. MILLER CO., MILWAUKEE

371106 1030