

CERTIFIED LAND CORNER RESTORATION

Index No. C-5

State of Wisconsin

County of Oneida } ss.

I Phillip J. Hansen, do hereby certify that on the 8th day of September, 1975, I found evidence of the quarter corner of section 5 and 6 Township 37, North, Range 11 East, Fourth Principal Meridian, as described hereon; and that from this evidence I established a new monument and accessories as described hereon to perpetuate the original location of this corner.



Resident witnesses:

Glen Parker

Jim Griffin

Herb Aschner

T37N R11E

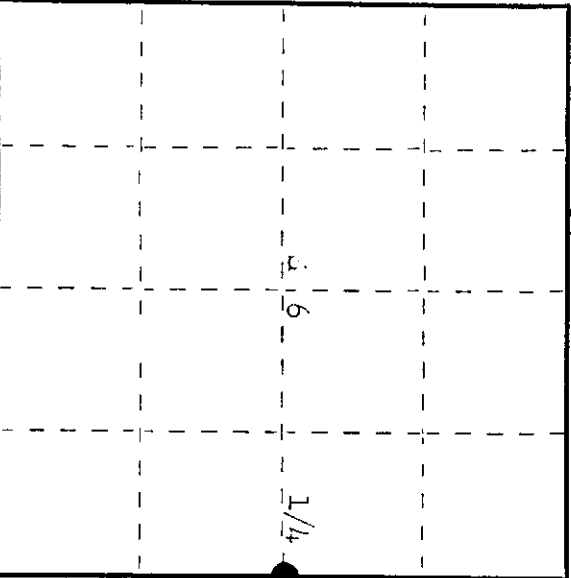 

○ = Corner monument restored.

History of original corner establishment:


Description of corner evidence found:

Recovered W.C. Lawrence's 5" cedar post, squared and scribed 1/4" x 1/4" in poor condition. Also found an old cedar joint buried in the oak beside the post.

Description of monument and accessories I established to perpetuate the original location of this corner.

Replaced cedar post with 2" iron pipe with brass cap stamped: monument projects 18" above ground. Corner sets in an open marsh 14 links west of a small creek that runs east out of Star Lake. as there was not trees available for OTS, set two 3/4" iron pipes with brass caps for reference corners. #1 North 30 links, #2 - 20 links, both scribed "W.C." Corner sets approximately 3 chains east of Stella Lake road.

T37N R11E
1/4 6 5
GR-1976

Dated at Waunakee, Wis., this 20th day of September, 1975.

Signature Walter S. Schneider Title registered land surveyor Registration No. 2498
(County Surveyor, Registered Land Surveyor, or other duly authorized official)

Office of Registrar of Deeds, County of Oneida I hereby certify that the within instrument was filed in this office for record on the 9th day of November, 1976 at 10:30 o'clock A.M.

(Registrar of Deeds)

By _____ Deputy

3711062000