CERTIFIED LAND CORNER RESTORATION

Index No. C-3

State of Wisconsin
County of Oneida } ss.

I Philip T. Hansen, do hereby certify that on the 9th day of September, 1976, I found evidence of the C 1/4 corner of Section 6 Township 37, North, Range 11 East, Fourth Principal Meridian, as described hereon; and that from this evidence I established a new monument and accessories as described hereon to perpetuate the original location of this corner.

Resident witnesses:

Glen Parker

Jim Claflin

Herb Majoner

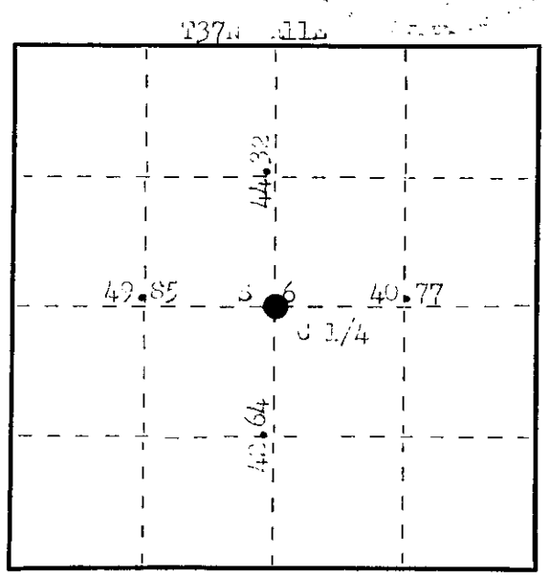

O = Corner monument restored.

History of original corner establishment:

Corner established by H.C. Lawrence, Registered Land Surveyor, in 1980. Ran E-W - 1/4 line and N-S 1/4 line. Corrected same and set C1/4 Corner 49.85 chains east of N 1/4 Corner and 44.32 south of N 1/4 corner. Set a 4" cedar post and marked WBTs - Spruce 5" S 80° W 35 links and Spruce 6" S 12° W 73 links. Corner is 40.77 chains west of 1/4 Corner and 42.64 chains North of S 1/4 Corner.

Description of corner evidence found:

Recovered 4" cedar post squared and scribed C 1/4 S 56, C 1/4 S 56, in fair condition.

No evidence of BTs.

Description of monument and accessories I established to perpetuate the original location of this corner.

Replaced 4" cedar post with 2½" Bernstein A-1 Federal Monument (aluminum with magnet in cap and base). Monument projects 18" above ground. Cap stamped:

BTs - Tamarack 4" S 59° W 26 links
Tamarack 3" W 33° W 34.4 links
Tamarack 3" W 13° E 44 links, all scribed 1/4 SF.

Monument and BTs painted blue.

T37N R11E
C 1/4 S 6
5498-1976

Dated at Rhinelander, Wis., this 20th day of September, 1976.

Signature Philip T. Hansen Title Registered Land Surveyor Registration No. S-498
(County Surveyor, Registered Land Surveyor, or other duly authorized official)

Office of Register of Deeds, County of Oneida, I hereby certify that the within instrument was filed in this office for record on the 9th day of November, 1976 at 10:35 o'clock A M.

Doris Verage Kuehn
(Register of Deeds)

By ..... Deputy

FORM 985 H. C. MILLER CO., MILWAUKEE

37110620020