

CERTIFIED LAND CORNER RESTORATION

Index No. B-3

State of Wisconsin

County of Oneida } ss.



History of original corner establishment:
H.C. Lawrence, Registered Land Surveyor, recovered an old 4" squared cedar post when he ran the N-S 1/4 line. This checked out when he ran the E-W 1/4 line of NW 1/4.

I, Philip T. Hansen, do hereby certify that on the 11th day of April, 1979, I found evidence of the NC 1/16 corner of the Section 6 Township 37, North, Range 11 East, Fourth Principal Meridian, as described hereon; and that from this evidence I established a new monument and accessories as described hereon to perpetuate the original location of this corner.

Resident witnesses:

Jim Claflin

Herb Wagoner

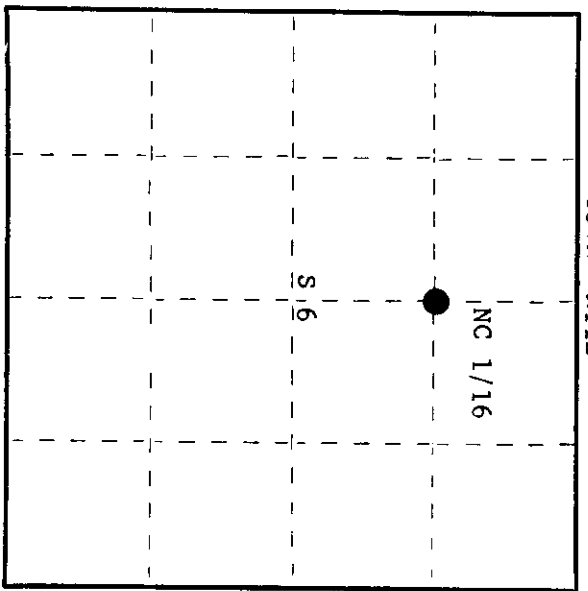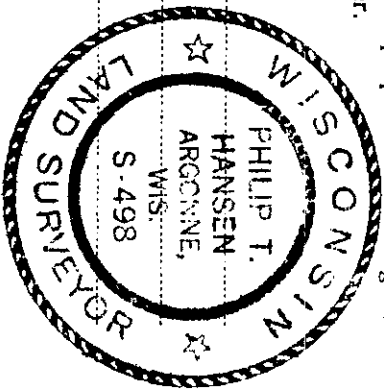

○ = Corner monument restored.

Description of corner evidence found:
Recovered Lawrence's 5" squared cedar post, scribed NC 1/16 S6 NC 1/16 S6 in good condition.
Recovered OBT's -
Cedar 7" S45°W 30.5 links, scribed S6 BT
Cedar 9" N5°E 11.0 links, now uprooted.

Description of monument and accessories I established to perpetuate the original location of this corner.
Replaced cedar post with 1 1/2" iron pipe with 2" brass cap, stamped:
Monument projects 1' above ground.
NBT - cedar 5" N12°E 15.7 links, scribed 1/16 BT

S498
T35N R11E
NC 1/16 S6
CPI-1979

Dated at Rhineland, Wis., this 24th day of April, 1979.

Signature Philip T. Hansen Title Registered Land Surveyor Registration No. S-498
(County Surveyor, Registered Land Surveyor, or other duly authorized official)

Office of Register of Deeds, County of Oneida, I hereby certify that the within instrument was filed in this office for record on the 14th day of May, 1979 at 1:30 o'clock P.M.

Doris George Kuehn
(Register of Deeds)

By Doris George Kuehn Deputy

3711063020