

CERTIFIED LAND CORNER RESTORATION

Index No. J-7



State of Wisconsin

County of Oneida } ss.

I, Phillip T. Hansen, do hereby certify that on the 15th day of June, 1977, I found evidence of the 1/4 corner of Sec. 8 and 17 Township 37 North, Range 11 East, Fourth Principal Meridian, as described hereon; and that from this evidence I established a new monument and accessories as described hereon to perpetuate the original location of this corner.

Resident witnesses:

- Glen Barker
- Jim Clafflin
- Herb Wagoner

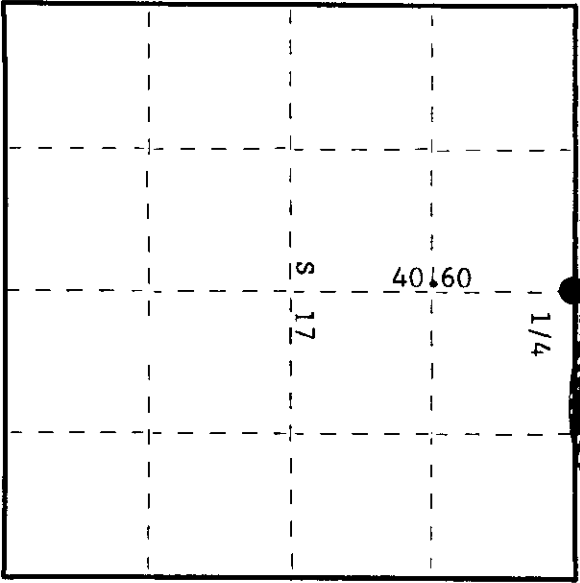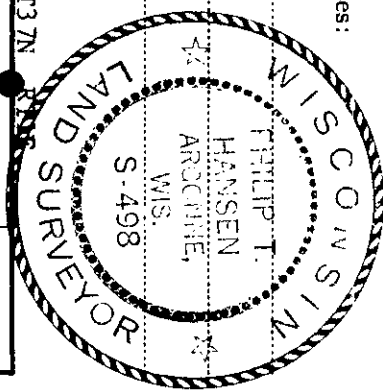

○ = Corner monument restored.

History of original corner establishment:

Original corner established by Wm. E. Dougherty, Deputy Surveyor, in 1859, from which Tamarrack 15" bears S29°W, 30 links; Tamarrack 18" bears N83°W, 55 links. Corner re-established by H.C. Lawrence, Registered Land Surveyor, in 1947. This corner was set on the basis of the north and south 1/4 line, Section 17, in centerline of old north-south 1/4 line road and in line with fence running west. Recovered a 6" cedar post, squared and scribed 1/4S, S8 1/4S, S17. Post sets 13 links east from the centerline of old north-south road. His field notes state that true corner is in the centerline of old north-south road.

Description of corner evidence found:

Found evidence of the old fence line running due west from this post. No evidence or records of any old BTs established.

Description of monument and accessories I established to perpetuate the original location of this corner.

Set a 1 1/2 x 2 1/2 foot iron pipe 4" below surface in centerline of old north-south road and in line with old fence to the west. Set a 2 1/2" Berntsen A-1 Federal Monument, aluminum with magnet in cap and base 25 links east for witness corner. Cap stamped:
 Monument projects 18" above ground.
 Marked NBT - White Spruce 9" N71°W, 71.4 links, scribed 1/4 BT.
 No other trees available for BTs.
 T37N 8 R11E
 1/4 S 17 W.C.
 W. 25 lks.
 S498 - 1977

Dated at Rhineland, Wis., this 21st day of June, 1977.

Signature: Phillip T. Hansen Title: Registered Land Surveyor Registration No. S-498
 (County Surveyor, Registered Land Surveyor, or other duly authorized official)

Office of Register of Deeds, County of Oneida
 Instrument was filed in this office for record on the 23rd day of June, 1977 at 12:40 o'clock P. M.

Dorcas Wagoner
 (Register of Deeds)

By: _____ Deputy