

CERTIFIED LAND CORNER RESTORATION

Index No. **G-9**

State of Wisconsin

County of **Oneida**

} ss.

I **Phillip T. Hansen**, do hereby

certify that on the **3rd** day of **February**, 19 **78**, I found

evidence of the **Quarter** corner of **Sec. 8 & 9**

Township **37**, North, Range **11 East**, Fourth Principal Meridian,



as described hereon; and that from this evidence I established a new monument and accessories as described hereon to perpetuate the original location of this corner.

Resident witnesses:

Glen Barker

Jim Clafflin

Herb Wagoner

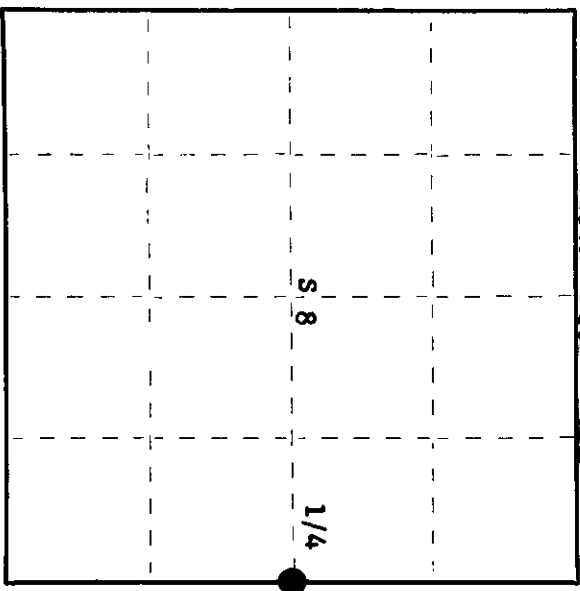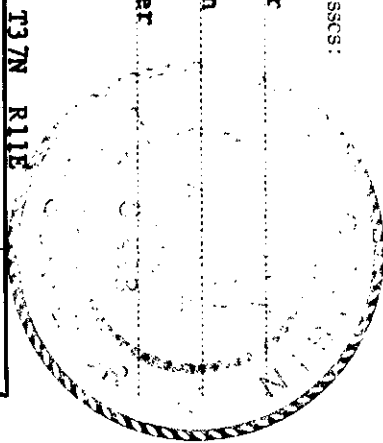

History of original corner establishment:

Original corner established by Wm. E. Dougherty, Deputy Surveyor, in 1859 from which Tamarack 6" bears S 74° W, 11 links and White Spruce 6" bears N 25° E, 13 links.

H.C. Lawrence, Registered Land Surveyor, recovered an old squared post here in 1947. No records of any BT's.

Description of corner evidence found:

Recovered a very old post, cedar, squared and scribed. Scribe marks S9 still visible. Post was in poor condition. No evidence of any BT's recovered.

Description of monument and accessories I established to perpetuate the original location of this corner.

Replaced old cedar post with 2 1/2" Bernitsen A-1 Federal Monument (O.C.) projecting 8" above ground. Cap stamped:

- Marked NBT's - Black Spruce 5" N15°W, 16.5 links **S498**
- Black Spruce 5" S10°W, 50.5 links **T37N**
- Black Spruce 6" S50°E, 45.6 links **S81 S9**
- Black Spruce 5" N18°E, 29.0 links **1/4**

Corner sets in a black spruce swamp. Set a 5' spruce picket along side of monument. **R11E 1978**

Dated at **Rhineland**, Wis., this **7th** day of **February**, 19 **78**

Signature **Phillip T. Hansen** Title **Registered Land Surveyor** Registration No. **S-498**
(County Surveyor, Registered Land Surveyor, or other duly authorized official)

Office of Register of Deeds, County of **Oneida** at **9:45** o'clock **P.** M. **7th** day of **February**, 19 **78** hereby certify that the within instrument was filed in this office for record on the

Signature **Dorcas Verge Kuehn**
(Register of Deeds)

By _____ Deputy

0007801123