

CERTIFIED LAND CORNER RESTORATION

Index No. A-17

State of Wisconsin

County of Oneida } ss.


I, Phillip T. Hansen, do hereby certify that on the 15th day of October, 1975, I found evidence of the S 1/16 corner of Sections 10 and 11

Township 37, North, Range 11, East, Fourth Principal Meridian,


as described hereon; and that from this evidence I established a new monument and accessories as described hereon to perpetuate the original location of this corner.

Resident witnesses:

Glen Barker  
Jim Clafflin

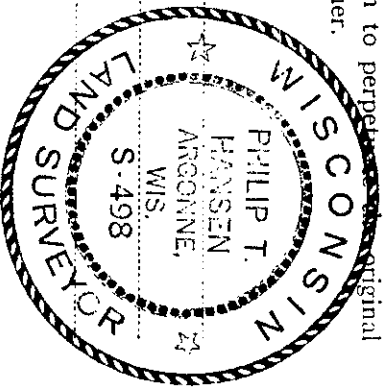

T37N R11E

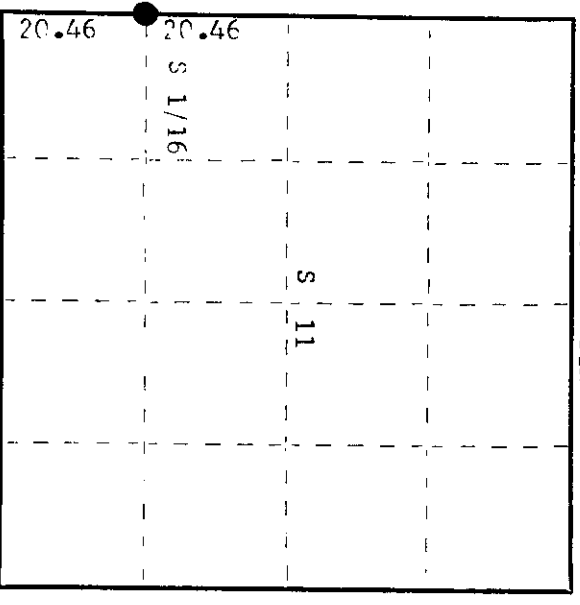

○ = Corner monument restored.

History of original corner establishment:

Corner established by H.C. Lawrence, Registered Land Surveyor, in 1960. Ran line S 4° 00' E from 1/4 corner between sections 10 and 11, 40.92 chains to close out 2 chains east of section corners 10, 11, 14 and 15. Set S 1/16 corner at 20.46 chains intermediate 1 chain west. Set 4" cedar post and marked NBT's - Hemlock 10" N25° 56' 56 links  
Sugar 14" N65° E 67 links

Description of corner evidence found:

Recovered 4" cedar post, squared and scribed S 1/16 S11, S 1/16 S10, in poor condition.  
Recovered CRT's - Sugar 14" N65° E 67 links (68 links) scribed S11 RT.  
Hemlock 10" N25° 56' 56 links, now down and dead, scribed S 1/16 RT.

Description of monument and accessories I established to perpetuate the original location of this corner.

Replaced cedar post with 1-1/2" iron rine with 2" brass cap, stamped:  
Marked NBT - Sugar 6" N56° W 62.7 links, scribed 1/16 RT.  
Set wood post beside new monument.

T37N R11E  
S 1/16 S10 + S11  
S498

Dated at Rhineland, Wis., this 26th day of November, 1979.

Signature Phillip T. Hansen Title Registered Land Surveyor Registration No. S-498  
County Surveyor, Registered Land Surveyor, or other duly authorized official

Office of Register of Deeds, County of Oneida. I hereby certify that the within instrument was filed in this office for record on the 17th day of December, 1979 at 1:30 o'clock P. M.

Doris Savage Fisher  
(Register of Deeds)

By: \_\_\_\_\_ Deputy

