

CERTIFIED LAND CORNER RESTORATION

Index No. J-21



State of Wisconsin

County of Oneida } ss.

I, Phillip T. Hansen, do hereby certify that on the 24th day of October, 1975, I found evidence of the Section corner of Sections 11, 12, 13, and 14 Township 37 North, Range 11 East, Fourth Principal Meridian, as described hereon; and that from this evidence I established a new monument and accessories as described hereon to perpetuate the original location of this corner.

Resident witnesses:

Glen Barker
Jim Clafflin

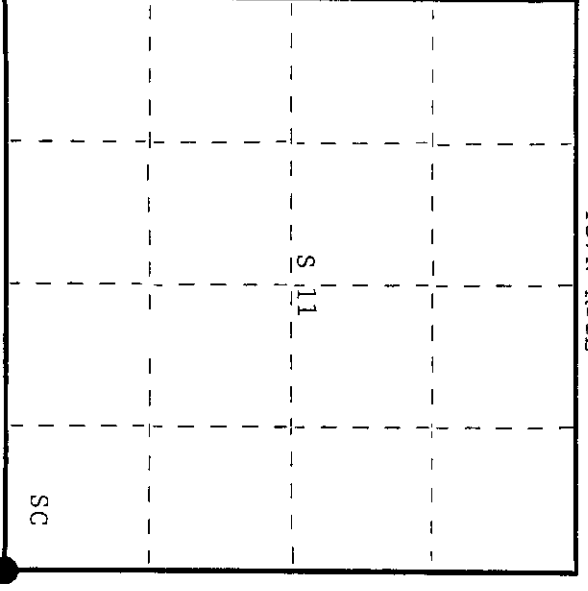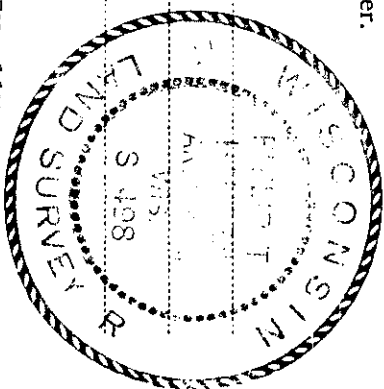

○ = Corner monument restored.

History of original corner establishment:

Original corner established by Wm. E. Dougherty, Deputy Surveyor, in 1859 from which tamarack 6" bears S25°E, 20 links and tamarack 5" bears N22°W, 30 links. Corner recovered by J.J. Melendy, Gagen Lumber Company surveyor, in 1918. Recovered point of old post and original tamarack stump N22°W, 30 links and original tamarack S33°E, 20 links (dead). Corner recovered by V.M. Maine, County Surveyor. Identified old scribed post and original BT: Tamarack 5" S22°E 20 links. Set iron pipe with brass cap and marked NBT's: Tamarack 4" N13½°E 42½ links, and Tamarack 4" N47°W 21½ links, and Tamarack 3" N67°E 12 links. Corner recovered by H.C. Lawrence, Registered Land Surveyor. Found Maine's iron pipe, original 5" tamarack S22°E 20 links and Maine's tamarack BT's. Description of corner evidence found:

Recovered Maine's 2-1/2" iron pipe with brass cap stamped - T37 R11

Also an old 3" cedar post, squared and scribed S11, S12, S13 beside 11 12
Maine's iron pipe. 14 13

Recovered OBT's: Tamarack 5" S22°E 20 links - original
Tamarack 4" N47°W 21½ links
Tamarack 4" N13½°W 42½ links
Tamarack 3" N67°E 12 links - all of which are now decayed stumps.

Description of monument and accessories I established to perpetuate the original location of this corner. As the iron pipe was in perfect condition, it was left in place and drove support stakes around it.

NBT's: Tamarack 3" S72°W 25.3 links - scribed SC BT
Tamarack 4" S13°E 39 links - scribed SC BT.
No other trees suitable for BT's.
Iron pipe and BT's painted blue.

Dated at Rhineland, Wis., this 6th day of November, 1975.

Signature: Phillip T. Hansen, Title: Registered Land Surveyor, Registration No. S-498
(County Surveyor, Registered Land Surveyor, or other duly authorized official)

Office of Register of Deeds, County of Oneida. I hereby certify that the within instrument was filed in this office for record on the 11th day of November, 1975 at 10:00 o'clock P.M.

Doris Verage Kuehn
(Register of Deeds)

By: Deputy