

CERTIFIED LAND CORNER RESTORATION

Index No. V-18

State of Wisconsin

County of Oneida } ss.

I Phillip T. Hansen, do hereby

certify that on the 17th day

of October, 1975, I found

evidence of the W-1/16

corner of Sections 11 and 14

Township 37, North, Range


11 East, Fourth Principal Meridian,

as described hereon; and that from this evidence

I established a new monument and accessories

as described hereon to perpetuate the original


location of this corner.

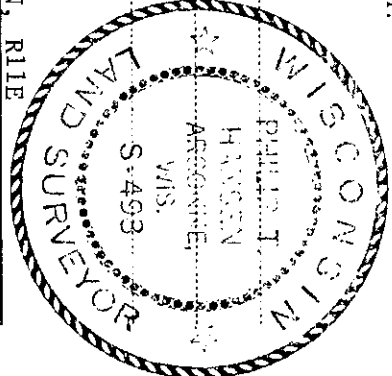

Resident witnesses:

Glen Barker

Jim Clafflin

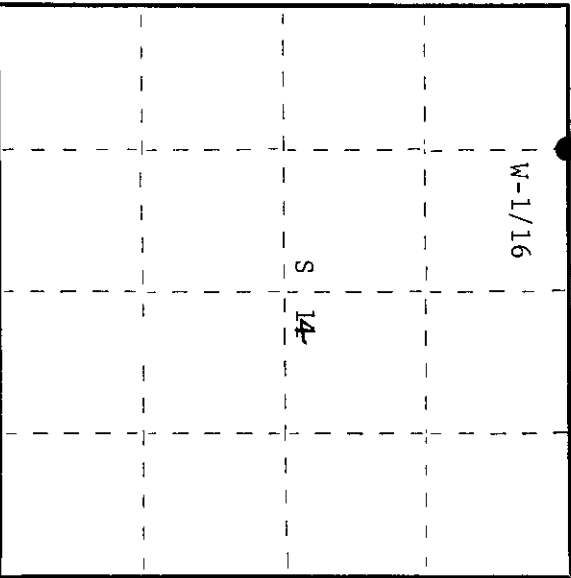

History of original corner establishment:  
 Corner recovered by H.C. Lawrence, Registered Land Surveyor, in 1960. Found an old cedar post squared and scribed 1/8-S 1/8-S. Also found OBT pine stump 15", S55°W, 3 links, origin unknown. Possibly, Melendy's corner, Gagen Lumber Company Surveyor.

Description of corner evidence found:  
 Recovered old 3" cedar post, squared and scribed 1/8-S 1/8-S. Also recovered OBT white pine stump, S55°W, 3 links.

Description of monument and accessories I established to perpetuate the original location of this corner.  
 Replaced 3" wood stake with 1" OD iron pipe with 2" brass cap stamped - S498  
 Post projects 18" above ground. T37N, R11E

NBT's - Hemlock 12" N49°E 32.4 links scribed 1/16 BT S | 2  
 Hemlock 12" S68°E 54.5 links scribed 1/16 BT W-1/16 S | 11

CPI-1975

Dated at Rhineland, Wis., this 23rd day of October, 1975.

Signature Phillip T. Hansen Title Registered Land Surveyor Registration No. S-498  
 (County Surveyor, Registered Land Surveyor, or other duly authorized official)

Office of Register of Deeds, County of Oneida  
 Instrument was filed in this office for record on the 5th day of December, 1975  
 at 10:30 o'clock AM.

Terrie Berge Kuehn  
 (Register of Deeds)

By Terrie Berge Kuehn Deputy

030011111M