

CERTIFIED LAND CORNER RESTORATION



Index No. **H-21**

State of Wisconsin }
 County of Oneida } ss.

I Philip T. Hansen, do hereby certify that on the 23rd day of October, 1975, I found evidence of the S-1/16 corner of Sections 11 and 12 Township 37, North, Range 11 East, Fourth Principal Meridian, as described hereon; and that from this evidence I established a new monument and accessories as described hereon to perpetuate the original location of this corner.

Resident witnesses:

Glen Barker
 Jim Claflin

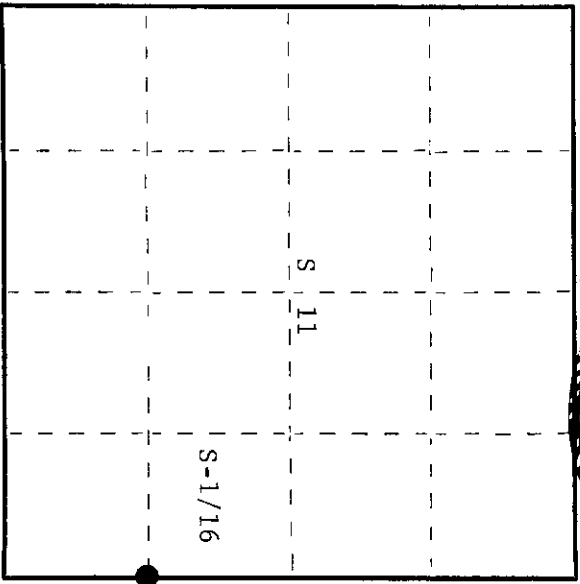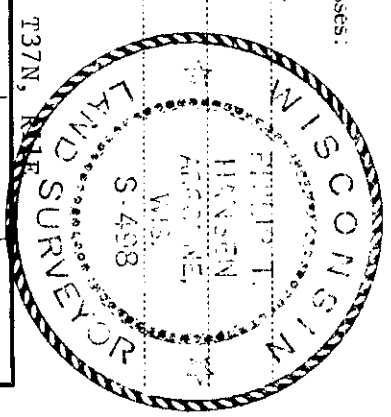

○ = Corner monument restored.

History of original corner establishment:
 Corner recovered by H.C. Lawrence, Registered Land Surveyor. Found a 2½" squared cedar post and OBT's - dead balsam 6", N30°W, 5 links and yellow birch 8", S25°E, 5 links, origin unknown. In 1946, he set a new cedar post and marked NBT's - cedar 9", N25°W, 15½ links and cedar 12", East, 28 links.

Description of corner evidence found:
 Recovered 4" cedar post, squared and scribed S-1/16 S11, S-1/16 S12, in fair condition. now a decayed stub
 Recovered OBT's - Yellow birch 8" S25°E 5.0 links
 Cedar 9" (10") N25°W 15.5 links (28 links) scribed S11 NBT
 Cedar 12" (10") East (N88°E) 17.5 links scribed S12 NBT
 Dead balsam 6" N30°W 5.0 links now a dead stub

Note - Lawrence had the distances to his BT's reversed.

Description of monument and accessories I established to perpetuate the original location of this corner. S498
 Replaced 4" cedar post with 1" OD iron pipe with 2" brass cap stamped - T37N, R11E
 No additional BT's established. S-1/16 S11 | S12
 Post and BT's painted blue. CPI-1975

Dated at Rhineland, Wis., this 23rd day of October, 1975.

Signature Philip T. Hansen Title Registered Land Surveyor Registration No. S-498
 (County Surveyor, Registered Land Surveyor, or other duly authorized official)
 Office of Register of Deeds, County of Oneida
 instrument was filed in this office for record on the 5th day of December, 1975
 at 10:10 o'clock A. M.

John A. Kuehn
 (Register of Deeds)

By _____ Deputy

371111000