

CERTIFIED LAND CORNER RESTORATION

Index No. **J-23**

State of Wisconsin

County of Oneida

ss.



I, Phillip T. Hanson, do hereby certify that on the 13th day of August, 1976, I found evidence of the quarter corner of section 12 and 13 Township 37 North, Range 11 East, Fourth Principal Meridian, as described hereon; and that from this evidence I established a new monument and accessories as described hereon to perpetuate the original location of this corner.

Resident witnesses:

Glen Barker

Jim Darlin

Herb Wagoner

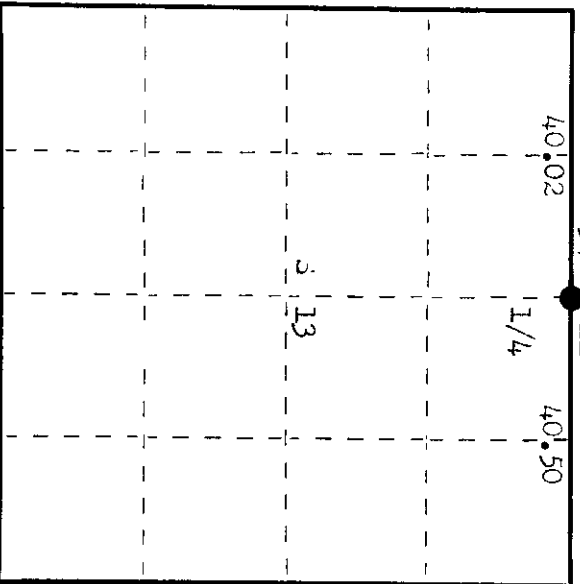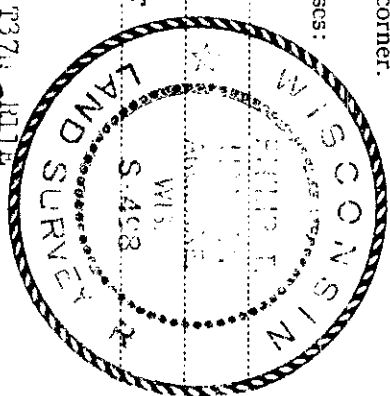

○ = Corner monument restored.

History of original corner establishment:

Original corner established by J.M. W. Duggert, Deputy Surveyor, in 1857, from Wisconsin Tarrack 10" bears N 70° E 9 links and Tarrack 10" bears S 31° E 11 links. Corner recovered by J.J. Jeland, Jagen Lumber & Cedar Company Surveyor, in 1918. Recovered original Tarrack N 70° E 9 links, marks plain, tree standing dead. Set new cedar post and marked WT's - Dead Tarrack 8" N 22° E, Dead Tarrack 10" N 15° E, 40 1/2 links, Dead Tarrack 10" N 37° E 40 1/2 links, Tarrack 9" S 22° E 4 1/2 links.

Description of corner evidence found:

Recovered a very old 6" cedar post, squared and scribed 1/4 S - 1/4 S, scribing still visible. Also recovered mine's 2 1/2" iron pipe with brass cap stumped. This pipe is one link north of cedar post.

Recovered WT - Tarrack (original) N 70° E 11 links, now down and dead, scribing 1/4 S still visible. 137 1/4 11

Tarrack stub S 8° E 21 links. 13
Tarrack stub S 65° E 11 links, scribed 1/4 S DT.

Description of monument and accessories I established to perpetuate the original location of this corner. as mine's post was in good condition but did not crack out to WT's as well as the cedar post, removed the post and set iron pipe in its hole.

Monument projects 24" above ground.
WT's - Tarrack 6" S 170° E 8.9 links.
Tarrack 7" S 84° E 35.8 links.
Tarrack 6" N 73° E 32.7 links, all scribed 1/4 DT.
Monument and DT's painted blue.

Dated at Minnelander, Wis, this 31st day of August, 1976.

Signature: *Phillip T. Hanson* Title: Registered Land Surveyor Registration No. 3-498
(County Surveyor, Registered Land Surveyor, or other duly authorized official)

Office of Register of Deeds, County of Oneida. I hereby certify that the within instrument was filed in this office for record on the 23rd day of September, 1976, at 1:00 o'clock P.M.

Debra Verage Fuchner
(Register of Deeds)

By: Deputy