

CERTIFIED LAND CORNER RESTORATION

Index No. **J-22**

State of Wisconsin

County of Oneida

ss.

I, Phillip T. Hansen, do hereby certify that on the 13th day of August, 1976, I found evidence of the 1/16

corner of Section 12 and 13

Township 37 North, Range 11 East, Fourth Principal Meridian,



as described hereon; and that from this evidence I established a new monument and accessories as described hereon to perpetuate the original location of this corner.

Resident witnesses:

Glen Barker

Jim Clafflin

Herb Masoner

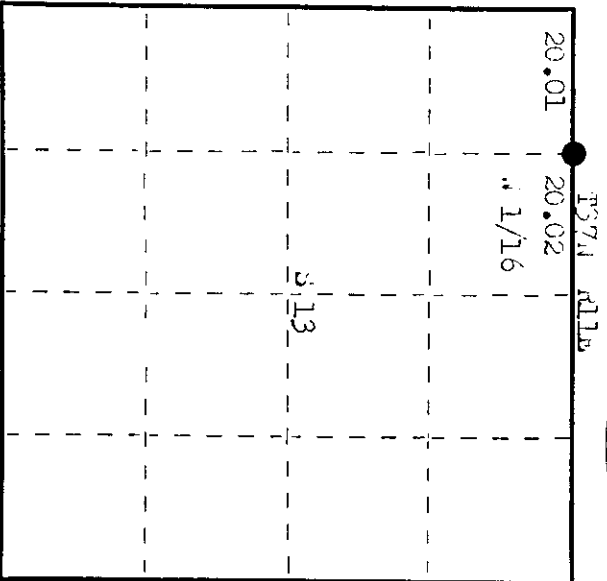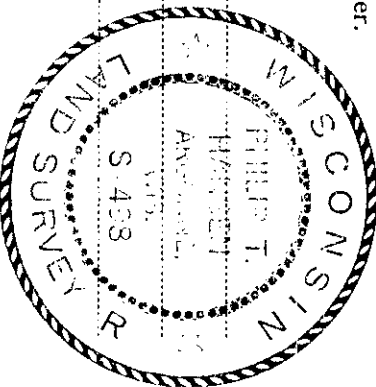

History of original corner establishment:

Corner established by J.J. Melendy, Cagen Lumber and Cedar Company surveyor, in 1918. Set 4" tamarack post and marked Tamarack 4" 15° 10 links, Tamarack 3" 78° 39 1/2 links

Corner established by W.H. Laine in 1935, set a 2" tamarack post.

Corner recovered by H.C. Lawrence, registered land surveyor, recovered Melendy's RT's. set new post.

Description of corner evidence found:

Recovered H.C. Lawrence's 3" tamarack post, square and scribed 12, 1/10 313, 1/16. Also recovered Laine's 2" tamarack post scribed 1/8, 5 links east of Lawrence's post. Recovered WRT's - Tamarack 4" 15° 10 links, now down and dead, scribing RT Visiole. Tamarack 3" 78-10 39.5 links, now a 4" stub, scribed RT.

Bearings and distances did not check out to either Laine's or Lawrence's post. By making cross ties and digging, recovered the point of old post, believed to be Melendy's so used this point for restoring corner.

Description of monument and accessories I established to perpetuate the original location of this corner.

Replaced Melendy's point with 1 1/2" iron pipe with 2" brass cap stamped: 1374 R11b 2498

Monument projects 18" above ground. WRT's - Tamarack 3" 12° 28.4 links, scribed RT. Tamarack 3" 78° 39.5 links, scribed RT. 1/16 12 13

This area is tag along and small tamarack. No other trees suitable for RT's. CFI-1976

Dated at Oneida, Wis. this 31st day of August, 1976

Signature: *Phillip T. Hansen* Title: Registered Land Surveyor Registration No. 2498
(County Surveyor, Registered Land Surveyor, or other duly authorized official)

Office of Register of Deeds, County of Oneida. I hereby certify that the within instrument was filed in this office for record on the 23rd day of September, 1976 at 2:10 o'clock P.M.

Lorne Torrey Fiehn
(Register of Deeds)

By: Deputy