CERTIFIED LAND CORNER RESTORATION

Index No. F-23

State of Wisconsin
County of Oneida } ss.

I Philip T. Hansen, do hereby certify that on the 16th day of August, 19 76, I found evidence of the NC 1/16 corner of Section 12 Township 37, North, Range 11 East, Fourth Principal Meridian, as described hereon; and that from this evidence I established a new monument and accessories as described hereon to perpetuate the original location of this corner.

Resident witnesses.

Glen Barker

Jim Claflin

Herb Wagoner

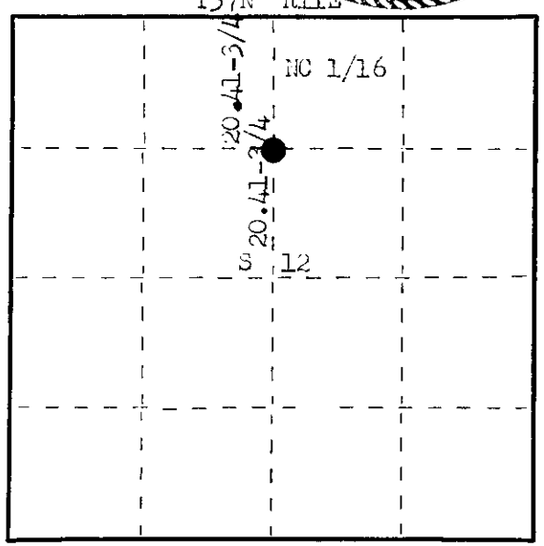

○ = Corner monument restored.

History of original corner establishment:
Original Corner established by V.A. Laine, Oneida County Surveyor, in 1935. Ran N-S and E-W 1/4 lines to establish C 1/4 Corner. Set NC 1/16 corner at 20.41-3/4 chains, equidistant between C 1/4 and N 1/4 line.
Set cedar post and marked BT's - Hemlock 9" S 39° E 48 links and Yellow Birch 5" North 7 links.
Corner recovered by H.C. Lawrence, Registered Land Surveyor, when he was cruising timber. Set new post.

Description of corner evidence found:
Recovered Lawrence's 4" cedar post, squared and scribed S1, NC 1/16, S1, NC 1/16 in fair condition. Post was scribed S1 instead of S12.

Recovered Laine's CBT - Hemlock 9" (12") S 39° E 48 links, top scribed NC 1/16 S1.
Yellow Birch 5" North 27 links, now a 5' stub, scribed S1.

Description of monument and accessories I established to perpetuate the original location of this corner.
Replaced 4" cedar post with 1½" OD iron pipe with 2" brass cap stamped:
Monument projects 18" above ground.
WBT's - Sugar 7" N 84° W 23.8 links, scribed 1/16 BT.
Corner sets North 8.5 chains from an old E-W logging road.
Monument and BT's painted blue.

S498
T37N R11E
NC 1/16 S | 12
CFI-1976

Dated at Rhinelander, Wis., this 1st day of September, 19 76.

Signature Philip T. Hansen Title Registered Land Surveyor Registration No. S-498
(County Surveyor, Registered Land Surveyor, or other duly authorized official)

Office of Register of Deeds, County of Oneida, I hereby certify that the within instrument was filed in this office for record on the 29th day of September, 19 76 at 2:30 o'clock P M.

Dora Verage Kuehn
(Register of Deeds)

By ..... Deputy

37N11E3200

FORM 985 H. C. MILLER CO., MILWAUKEE