

CERTIFIED LAND CORNER RESTORATION

Index No. N-25



State of Wisconsin

County of Oneida } ss.

I Philip F. Hansen, do hereby certify that on the 8th day of August, 1976, I found evidence of the Section corner of S13, 18, 19, 24 Township 37, North, Range 11 East, Fourth Principal Meridian, as described hereon; and that from this evidence I established a new monument and accessories as described hereon to perpetuate the original location of this corner.

Resident witnesses:

Glen Barker
Jim Claffin
Herb Lagoner

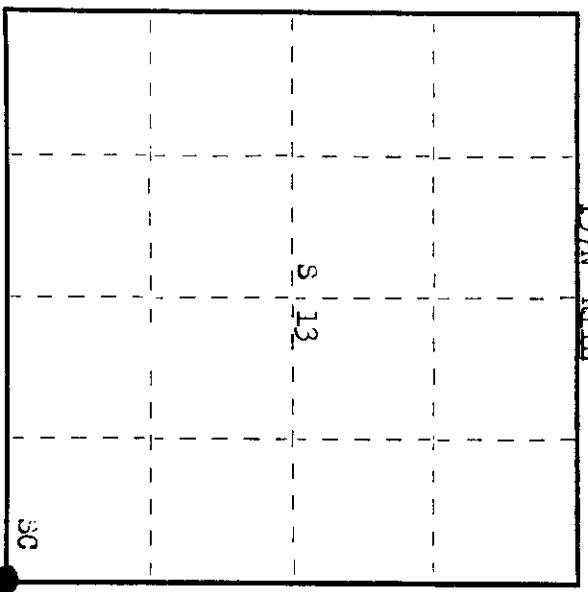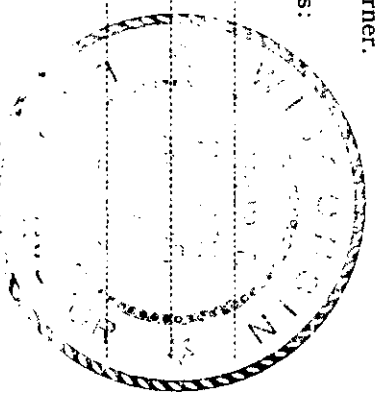

○ = Corner monument restored.

History of original corner establishment: Original corner established by Alfred Hillard, Deputy Surveyor, in 1857, from which Cedar 6" bears N 55° W 23 lks, spruce 10" bears W 61° E 46 lks, spruce 10" bears S 69° E 16 lks and Tamarack 12" bears S 20° W 8 lks. Corner recovered by V.M. Kaine, County Surveyor, Oneida County. Round scribed post, mutilated some, original bearing tree, Green and standing, Cedar 6" N 55° W 23 lks and stump of Tamarack 12" S 20° W 8 lks. Set 2 1/2" iron pipe with brass cap and marked MBTs - Cedar 7" S 36° W 14 lks, Cedar 8" N 74° W 53 lks, Cedar 4" N 70° E 21 1/2 lks. Corner recovered by H.C. Lawrence, Registered Land Surveyor, in 1948. Round Kaine's iron pipe and original 6" cedar and stump of tamarack 12" S 20° W 8 lks.

Description of corner evidence found:

- Recovered 2 1/2" iron pipe with brass cap stamped. R S13 | S18 R
- Monument projects 18" above ground. 11 S24 | S19 12
- Recovered original Cedar BT 6" (14") N 55° W 23 lks.
- Cedar 7" (10") S 36° W (S 46° W) 14 lks, scribe marks visible.
- Cedar 8" (10") N 74° W 53 lks (54 lks), scribed S13 BT.
- Cedar 4" N 70° E 21.5 lks.
- Recovered H.C. Lawrence's cedar post, squared and scribed S13, S18, S19, S24 in fair condition 4 lks from iron pipe.

Description of monument and accessories I established to perpetuate the original location of this corner. as Kaine's iron pipe was in excellent condition and checked out the calls to original Cedar BT, it was left as found. Thopped Lawrence's wood post next to Kaine's iron pipe. MBTs - Cedar 6" S 66° W 49.7 lks, scribed 36 BT. Cedar 8" S 9° W 59 lks, scribed 36 BT. Monument and BTs painted blue.

Dated at Rhineland, Wis., this 10th day of August, 1976

Signature Philip F. Hansen Title Registered Land Surveyor Registration No. 498
County Surveyor, Registered Land Surveyor, or other duly authorized official

Office of Register of Deeds, County of Forest County
Instrument was filed in this office for record on the 8th day of August, 1976
at 1:30 o'clock P.M.

James George Fisher
(Register of Deeds)

By _____ Deputy

00001111M