

CERTIFIED LAND CORNER RESTORATION

Index No. N-24



State of Wisconsin

County of Oneida } ss.

I, Phillip T. Hansen, do hereby certify that on the 30th day of August, 1976, I found evidence of the E 1/16 corner of section 12 and 24 Township 37 North, Range 11 East, Fourth Principal Meridian, as described hereon; and that from this evidence I established a new monument and accessories as described hereon to perpetuate the original location of this corner.

Resident witnesses:

Glen Barker  
Jim Claflin  
Herb Masoner

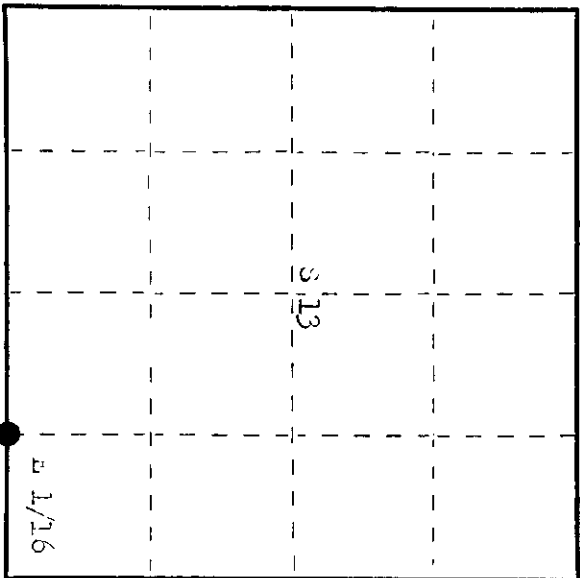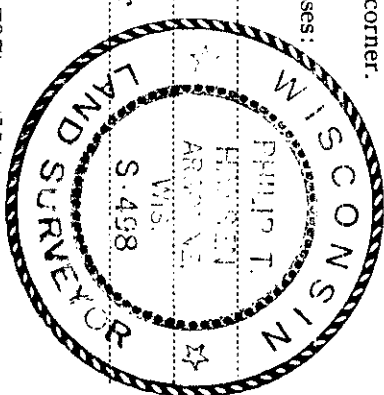

○ = Corner monument restored.

History of original corner establishment:

Original corner established by Wm. Haine, County Surveyor. Ran random line east from S<sub>4</sub> corner 44.332 chains, closed out 1.202 chains south of section corner. set E 1/16 corner post at 22.17 chains, 634 links north. Marked BT's - Maple 12" x 35" x 17 links and Maple 12" x 36" x 31 links. Corner recovered by H.C. Lawrence, registered Land Surveyor. set post.

Description of corner evidence found:

Recovered H.C. Lawrence's cedar post, squared and scribed, 213 x 1/16 x 24 in fair condition. a rock cairn had been placed around base of post.  
Recovered BT's - Maple 12" (20") x 35" x 17 links, scribing crown over.  
Maple 12" x 36" x 31 links - falls on west edge of 200 line run.

Description of monument and accessories I established to perpetuate the original location of this corner.

Replaced cedar post with 1 1/2" OD iron pipe with 2" brass cap secured.  
Monument projects 24" above ground.  
BT - Sugar 7" x 70" x 36.5 links, scribed 1/16 BT.  
Monument and BT's painted blue.

3498  
T37N R11E  
E 1/16 S 13  
24  
S1-1-1976

Dated at Rhinelander, Wis., this 30th day of August, 1976

Signature Phillip T. Hansen Title Registered Land Surveyor Registration No. 5478  
(County Surveyor, Registered Land Surveyor, or other duly authorized official)

Office of Register of Deeds, County of Oneida  
I hereby certify that the within instrument was filed in this office for record on the 23rd day of September, 1976 at 1:02 o'clock P.M.

Terese Leverage Puchner  
(Register of Deeds)

By: Deputy

0100211112