

CERTIFIED LAND CORNER RESTORATION

Index No. N-23

State of Wisconsin



County of Oneida } ss.

I Philip T. Hansen do hereby certify that on the 6th day of August, 1976, I found evidence of the quarter corner of Section 13 and 24 Township 37 North, Range 11 East, Fourth Principal Meridian, as described hereon; and that from this evidence I established a new monument and accessories as described hereon to perpetuate the original location of this corner.

Resident witnesses:

Jim Claffin

Herb Wagoner

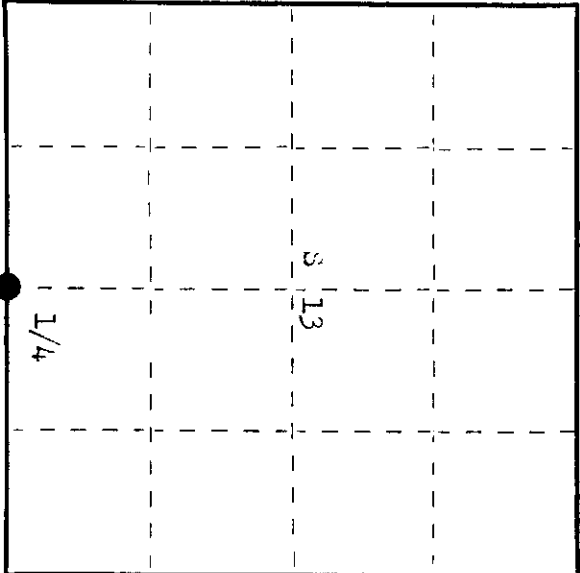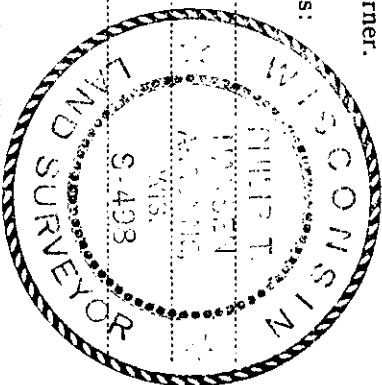

○ = Corner monument restored.

CERTIFIED LAND CORNER RESTORATION

Index No. N-23

History of original corner establishment: Original Corner established by Wm. S. Dougherty, Deputy Surveyor, in 1859, from which Birch 20" bears S 50° E 12 lks and Birch 15" bears N 25° W 17 lks.

Corner recovered and restored by Wm. Maine, County Surveyor, recovered old scribed post and original Birch BT 20" S 50° E 12 lks, down and decayed but old scribe marks plain. Set 2 1/2" iron pipe with brass cap. Marked NBT - Hemlock 12" N 42° W 25 lks and Hemlock 7" N 84° W 30 1/2 lks.

Corner recovered by H.C. Lawrence, Registered Land Surveyor, in 1954. Original Birch almost completely decayed. Made NBT - ash 11" N 25° W 17 1/2 lks, Hemlock 12" was standing green. Description of corner evidence found:

Recovered Hemlock 12" (18") N 42° W 25.0 lks, scribed 1/4" brass cap stamped. ash 11" (18") N 25° W 17.5 lks (19.7 lks), scribed NBT.

Recovered NBTs - Hemlock 12" (18") N 42° W 25.0 lks, scribed 1/4" brass cap stamped.

Monument projects 28" above ground. S13  
S24

Description of monument and accessories I established to perpetuate the original location of this corner. As the 2 1/2" iron pipe and brass cap was in good condition, it was left in place.

Added 498, T37N R11E, CH-1976 stamping to cap. NBTs - sugar 8" S 56° E 36.7 lks, scribed 1/4 BT. sugar 8" N 12° W 50.2 lks, scribed 1/4 BT. Removed H.C. Lawrence's post and laid it beside iron pipe.

Dated at Whiteland, Wis., this 17th day of August, 1976.

Signature Philip T. Hansen Title Registered Land Surveyor Registration No. 5498  
(County Surveyor, Registered Land Surveyor, or other duly authorized official)

Office of Register of Deeds, County of Oneida. I hereby certify that the within instrument was filed in this office for record on the 22nd day of September, 1976 at 10:00 o'clock M.

Thomas Verage Kuehn  
(Register of Deeds)

By Deputy Deputy

800021123