

CERTIFIED LAND CORNER RESTORATION

Index No. **N-22**

State of Wisconsin

County of Oneida } ss.



History of original corner establishment: Corner established by J.J. Melendy in 1915. Set post and marked STs - Hemlock 16" N 85° E 38 lks, Hemlock 10" S 29½° E 16 lks, Hemlock 10" N 89-3/4° W 27½ lks.

Corner recovered by V.M. Kaine, County Surveyor, claims to have set post from Melendy's BT. Set IBTs - Hemlock 16" N 85° W 23½ lks and Hemlock 12" N 80° E 55 lks.
 Corner recovered by H.C. Lawrence, Registered Land Surveyor, in 1954. Set new post.

I, Phillip T. Hansen, do hereby certify that on the 6th day of August, 1976, I found evidence of the N 1/16 corner of Section 13 and 24 Township 37 North, Range 11 East, Fourth Principal Meridian, as described hereon; and that from this evidence I established a new monument and accessories as described hereon to perpetuate the original location of this corner.

Resident witnesses:

Jin Clafin
 Herb Lagoner

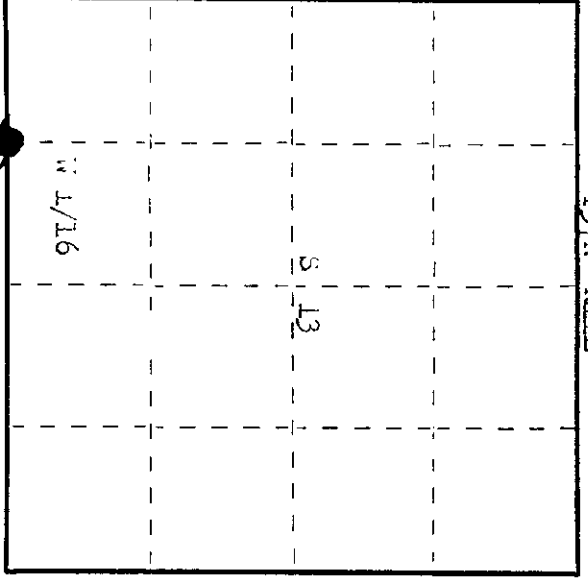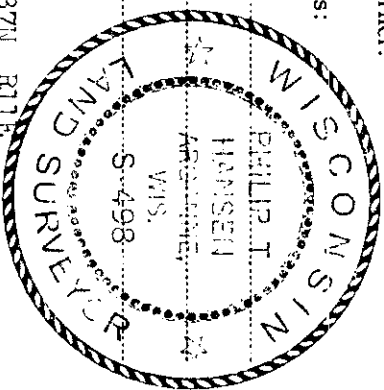

○ = Corner monument restored.

Description of corner evidence found: recovered 6" squared cedar post laying down and rotted, Post scribed N 1/16. Also recovered H.C. Lawrence's post in fair condition scribed N 1/16 S13, N 1/16 S24. This post was 37 lks from Kaine's. Will accept Kaine's location as he claims to have found Melendy's BTs.
 Recovered BTs - Hemlock 10" S 85° E 23.5 lks, now a cut off stump.
 Hemlock 12" N 80° E 52.0 lks, now a cut off stump.

Description of monument and accessories I established to perpetuate the original location of this corner.
 Replaced Kaine's post with 1 1/2" iron pipe with 2" brass cap stamped.
 Monument projects 24" above ground.
 IBTs - Sugar 0" N 72° E 10.1 lks, scribed 1/16 BT.
 Sugar 8" N 33° E 44.5 lks, scribed 1/16 BT.
 Monument and BTs painted blue.
 H.C. Lawrence's post placed along side new iron pipe
 T37N R11E
 S 13
 1/16
 S 498
 S 13
 1/16
 S 24
 GPI-1976

Dated at Oneida, Wis., this 17th day of August, 1976

Signature: *Phillip T. Hansen* Title: Registered Land Surveyor Registration No. S-498
 County Surveyor, Registered Land Surveyor, or other duly authorized official

Office of Register of Deeds, County of Oneida. I hereby certify that the within instrument was filed in this office for record on the 22nd day of September, 1976 at 1:05 o'clock P.M.

George Verage Truckner
 (Register of Deeds)

By: Deputy

371130030