

CERTIFIED LAND CORNER RESTORATION

Index No. 17-23

State of Wisconsin } ss.
 County of Oneida

I Phillip T. Hansen, do hereby
 certify that on the 3rd day
 of August, 1975, I found

evidence of the 30 1/16
 corner of section 13
37 Township North, Range
11 east, Fourth Principal Meridian,



as described hereon; and that from this evidence
 I established a new monument and accessories
 as described hereon to perpetuate the original
 location of this corner.

Resident witnesses:

Glen Jorker

Jim Staffin

Herb Johnson

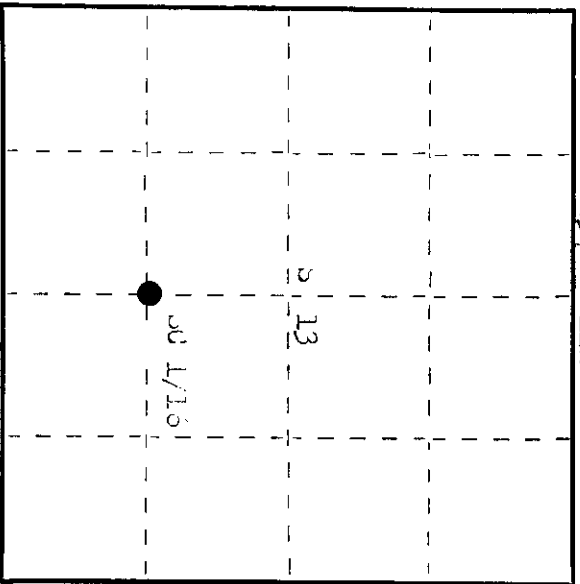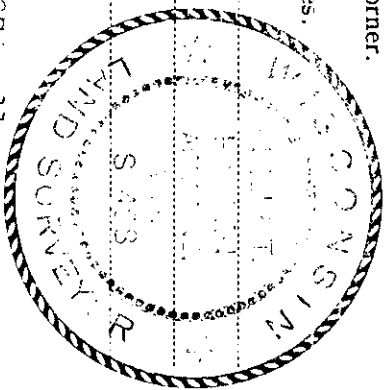

○ = Corner monument restored.

History of original corner establishment:

Original corner established by J.J. Melendy, surveyor for paper number and Cedar Co. in 1918. Set 4 x 4 cedar post and marked NPT's - headlock 9" north 2 links and headlock 12" S 87° " 13 links.

Corner recovered by H.C. Lawrence, registered land surveyor, in 1954. Recovered Melendy's 4" x 4" cedar post. Set new post and marked NPT's - Wash 10" north 17 1/2 links and Wash 12" N 70° E 20 1/2 links.

Description of corner evidence found:

Recovered H.C. Lawrence's 4" cedar post, squared and scribed 313 30 1/16 37 in poor condition. Also recovered pieces of old post laying beside it.

Recovered 4" x 4" cedar post - Wash 10" north (N 6° E) 17.5 links, scribed 30 1/16 NPT. Wash 12" (16") N 70° E (N 74° E) 20.5 links, scribed 30 1/16 NPT. Headlock 12" (18") S 87° " 13 links, scribing grown over. Headlock 9" north 2 links, now 2 1/2" stung, scribed 31.

Description of monument and accessories I established to perpetuate the original location of this corner.

Replaced 4" cedar post with 1 1/2" 30 iron pipe with 2" brass cap stamped: 1371 ALL
 Placed 1 small rock cairn around base. 3498
 No additional NPT's established. 1371 ALL
 Monument and PT's painted blue. 30 1/16 37
 JPI-1975

Dated at Oneida, Wis. this 30th day of August, 1975.

Signature Phillip T. Hansen Title Registered Land Surveyor Registration No. 2498
 (County Surveyor, Registered Land Surveyor, or other duly authorized official)

Office of Register of Deeds, County of Oneida I hereby certify that the within
 instrument was filed in this office for record on the 23rd day of September, 1975
 at 10:00 o'clock P. M.

Barbara Neavage Kuehn
 (Register of Deeds)

By: _____ Deputy

37113 1020