



CERTIFIED LAND CORNER RESTORATION

Index No. **L-25**

State of Wisconsin } ss.
 County of Oneida }

I, Philip T. Hansen, do hereby certify that on the 2nd day of August, 1976, I found evidence of the quarter corner of Sec. 13 and 18 Township 37 North, Range 11 East, Fourth Principal Meridian, as described hereon; and that from this evidence I established a new monument and accessories as described hereon to perpetuate the original location of this corner.

Resident witnesses:
 Glen Barker
 Jim Claflin
 Herb Wagoner

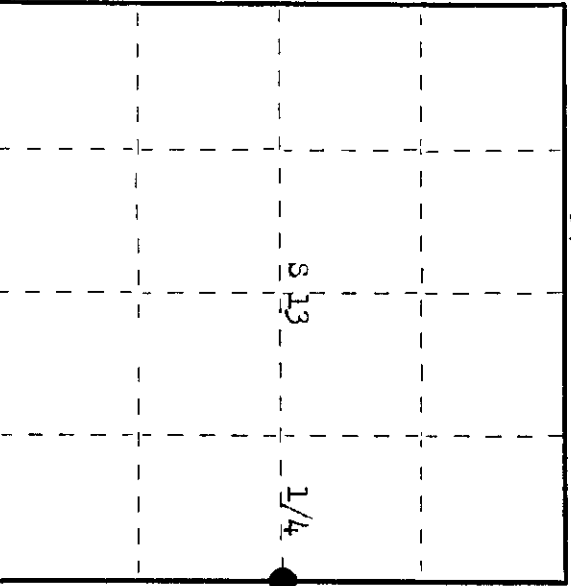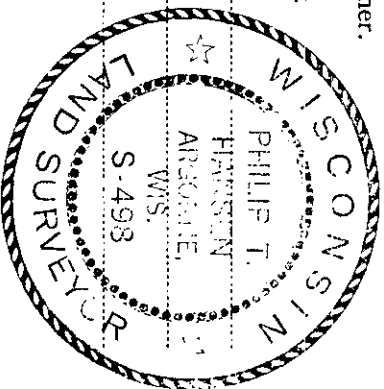

○ = Corner monument restored.

History of original corner establishment: Original Corner established by Alfred Willard, Deputy Surveyor, in 1857, from which white Pine 12" bears N 16° W 43 lks and Tamarack 10" bears S 71° E 8 lks.
 Corner recovered by J.J. Melendy, in 1918. Recovered old post and original W. Pine BT. Tamarack was gone. Set new corner post and marked NBTs - Birch 9" S 71° W 22 lks and Birch 10" S 81° E 38 lks.

Corner recovered by V.M. Maine, County Surveyor, Oneida County. Recovered post, stump of original W. Pine BT and Melendy's BTs. Set new iron pipe with brass cap.
 Corner recovered Maine's iron pipe and Melendy's post. Upon digging found point of original stake. Set new post, checked to Melendy's BTs.
 Description of corner evidence found:

Recovered Melendy's old post laying down, Lawrence's squared and scribed 4" cedar post scribed 1/4" S13 R11E, 1/4" S18 R12E, also laying down.
 Recovered Maine's iron pipe with brass cap standing in good condition, although not set in ground very deep. Cap stamped T37N R11 Sec. 13/S13 1/4.
 Recovered UBT - "W. Pine 12" N 16° W 43 lks.
 Recovered Melendy's BT - Birch 10" (12") S 81° E 38 lks, scribed 1/4" S18. Birch 9" S 71° W 22 lks, down and decayed.

Description of monument and accessories I established to perpetuate the original location of this corner. As iron pipe was not set very deep, it was extracted from ground and reset to project 24" above ground. Restamped brass cap.

NBT - Cedar 6" N 46° E 48.6 lks, scribed 1/4 BT.
 Hemlock 8" S 37° E 15.7 lks, scribed 1/4 BT.
 Hemlock 6" N 18° E 45.5 lks, scribed 1/4 BT.
 Corner is 5 chains south of E-W logging road.
 Monument and BTs painted blue.

T37N
 R S13 1/4 S18 R
 11 12

Dated at Rhinelander, Wis. this 10th day of August, 1976.
 Signature *Philip T. Hansen*, Title Registered Land Surveyor, Registration No. 5498
 County Surveyor, Registered Land Surveyor or other duly authorized official)

Office of Register of Deeds, County of Oneida.
 Instrument was filed in this office for record on the 22nd day of September, 1976 at 1:00 o'clock P.M.

Dorcas Verage Kuehn
 (Register of Deeds)

By _____ Deputy