



CERTIFIED LAND CORNER RESTORATION

Index No. **K-23**

State of Wisconsin }  
 County of Ozaukee } ss.

I, Philip P. Hansen, do hereby certify that on the 3rd day of August, 1976, I found evidence of the NC 1/16 corner of Section 13 Township 37, North, Range 11 East, Fourth Principal Meridian, as described hereon; and that from this evidence I established a new monument and accessories as described hereon to perpetuate the original location of this corner.

Resident witnesses:  
Glen Barker  
Jim Martin  
Herb Mackoner

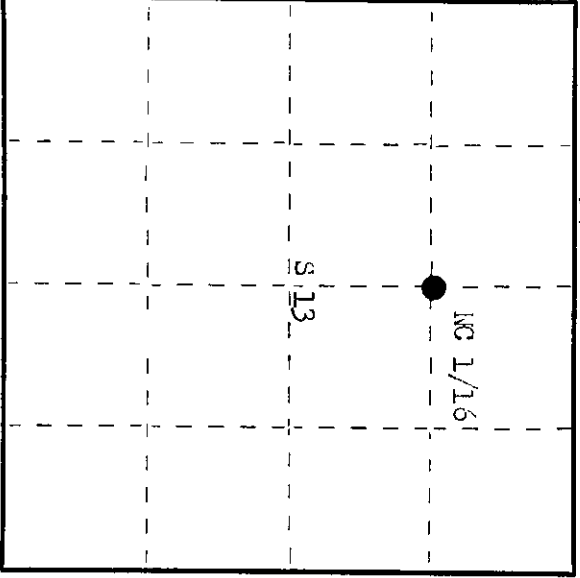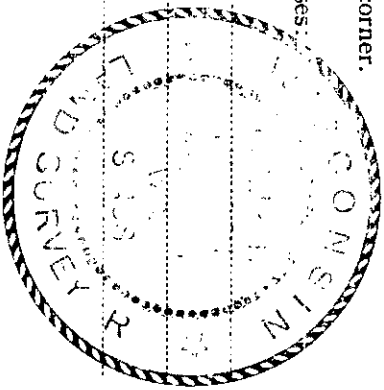

○ = Corner monument restored.

History of original corner establishment:

Original corner established by J.J. Melendy, Wagon Lumber and Cedar Co. surveyor, in 1918. Set a 5 x 5" cedar post and marked pine stump 24" S 35° W 40 links for ST. Corner recovered by H.V. Lawrence, registered land surveyor, in 1954.

Description of corner evidence found:  
 recovered very old 3" squared cedar post in poor condition.  
 recovered 3BT - pine stump 24" S 35° W 40 links, scribed 1/16 ST.

Description of monument and accessories I established to perpetuate the original location of this corner.  
 replaced 6" cedar post with 1 1/2" OD iron pipe within 2" brass cap stamped:  
 monument projects 18" above ground. 2498  
 3BT's - Hellock 3" S 78° W 12.5 links, scribed 1/16 BT. 1304 rdle  
 Hellock 12" S 40° W 14.2 links 13  
 monument and BT's painted blue. NC 1/16  
CPT-1976

Dated at Waukegan, Wis., this 30th day of August, 1976

Signature: Philip P. Hansen Title: Registered Land Surveyor Registration No. 2498  
 (County Surveyor, Registered Land Surveyor, or other duly authorized official)  
 Office of Register of Deeds, County of Ozaukee  
 Instrument was filed in this office for record on the 23rd day of September, 1976  
 at 1:00 o'clock P. M.

Doris Terape Kuehn  
 (Register of Deeds)

By: \_\_\_\_\_ Deputy

371133028