CERTIFIED LAND CORNER RESTORATION

Index No. N-21

State of Wisconsin
County of Oneida } ss.

I Philip T. Hansen, do hereby certify that on the 5th day of August, 19 76, I found evidence of the Section Corner corner of Sec. 13, 14, 23, 24 Township 37, North, Range 11 East, Fourth Principal Meridian, as described hereon; and that from this evidence I established a new monument and accessories as described hereon to perpetuate the original location of this corner.

Resident witnesses:

Glen Barker

Jim Claflin

Herb Wagoner

T37N R11E

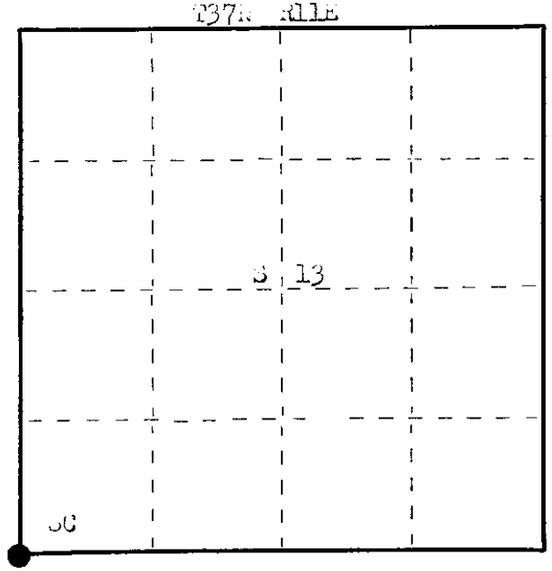

○ = Corner monument restored.

History of original corner establishment: Original Corner established by [illegible] Dougherty, Deputy Surveyor, in 1857, from which Cedar 10" bears S 70° E 10 links and Cedar 8" bears N 12° W 15 links.
Corner recovered and restored by V.H. Maine, County Surveyor, in 1935. Recovered scribed post and original BT's - Cedar 10" S 70° E 10 links (stump, but marks C.R.) Cedar 8" N 12° W 15 links nearly gone.
Set 2½" iron pipe and marked MBT's - Cedar 5" N 15° W 30 links, cedar 7" N 56° E 30 links, Cedar 4" S 21° W 35½ links and cedar 18" S 45° E 48 links.
Corner recovered by H.C. Lawrence, Registered Land Surveyor, recovered iron pipe and Maine's BT's.

Description of corner evidence found:
Recovered 2½" iron pipe with brass cap. Also 8" squared and scribed cedar post in poor condition. Post scribed S13, S14, S23, S24. Corner sets in wet cedar swamp.
Recovered BT's - Cedar 5" N 15° E 30.0 links, now a lead stub, scribed S14 BT.
Cedar 4" S 21° W 35.5 links, blown over.
Cedar 5" S 14° E 30.5 links, scribed S24 BT.
Original cedar stump 10" S 70° E 10.0 links, scribing not readable.

Description of monument and accessories I established to perpetuate the original location of this corner.
As Maine's iron pipe and brass cap were in good condition, drove support stakes around sides. Added stamping to supplement his stamping, now stamped:
Monument projects 20" above ground.
BT's - Cedar 5" N 54° E 47.3 links, scribed S3 BT.
Cedar 5" S 7° W 30.4 links, scribed S6 BT.
Monument and BT's painted blue.

S498
T37N
S14 | S13
S23 | S24
R11E
C.1-1976

Dated at Rhinelander, Wis., this 30th day of August, 19 76.

Signature Philip T. Hansen Title Registered Land Surveyor Registration No. S-498
(County Surveyor, Registered Land Surveyor, or other duly authorized official)

Office of Register of Deeds, County of Oneida, I hereby certify that the within instrument was filed in this office for record on the 23rd day of September, 19 76 at 1:00 o'clock P. M.

Doris Verage Kuehn
(Register of Deeds)

By ..... Deputy

FORM 985 H. C. MILLER CO., MILWAUKEE

371140000