

CERTIFIED LAND CORNER RESTORATION



Index No. N-20

State of Wisconsin }
 County of Oneida } ss.

I Philip A. Hansen, do hereby certify that on the 17th day of August, 1976, I found evidence of the corner of section 14 and 23 Township 37 North, Range 11 East, Fourth Principal Meridian, as described hereon; and that from this evidence I established a new monument and accessories as described hereon to perpetuate the original location of this corner.

Resident witnesses:

Glen Barker
 Jim Staffin
 Herb Magoner

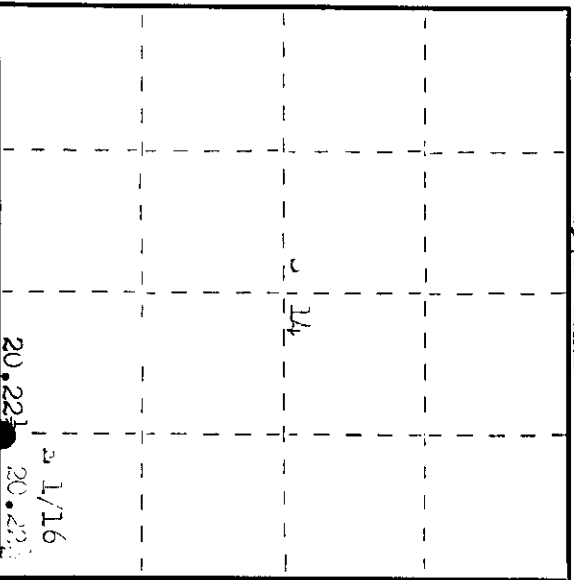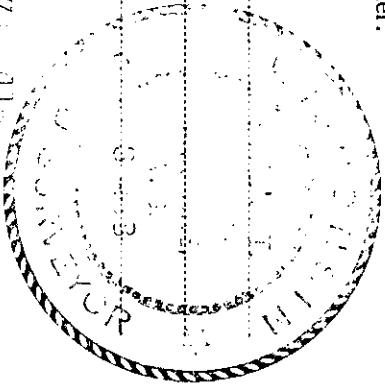

○ = Corner monument restored.

History of original corner establishment:

Corner established by T. ... and oneida County Surveyor, in 1938. ... from 1/4 corner section 14 and 23, 40.45 chains to close out 158 links north of section corner 13, 14, 22, 23. Set on 1/16 at 20.222 chains 79 links south. Set cedar post and marked with 5" spruce 4" x 1 1/2" x 34 links, spruce 4" x 25" x 27 links, spruce 5" x 29" x 52 links. Corrected bearing 0° 40'.

Description of corner evidence found:

Recovered on squared cedar post scribed 1/8, 1/8. Post was in poor condition. Recovered on spruce 5" x 29" x 52.5 links, now a decayed stump. Black spruce 4" x 25" x 30" x 20.7 links, scribed 1/8 on (dead).

Description of monument and accessories I established to perpetuate the original location of this corner.

Replaced on cedar post with 1 1/2" x 1/2" iron pipe with 2" brass cap scribed: monument projects 1" above ground. 137, 111
 with - Black spruce 5" x 80" x 44.6 links, scribed 1/16 on 137, 111
 Black spruce 5" x 150" x 55.3 links, scribed 1/16 on 137, 111
 Monument and with painted blue. 1/16 14
 23
 JPI-1976

Dated at Oneida, Wis. this 1st day of September, 1976.

Signature Philip A. Hansen Title Registered Land Surveyor Registration No. 498
 (County Surveyor, Registered Land Surveyor, or other duly authorized official)

Office of Register of Deeds, County of Oneida. I hereby certify that the within instrument was filed in this office for record on the 29th day of September, 1976, at 2:30 o'clock P. M.

Jessie Bergey Fushkin
 (Register of Deeds)

By _____ Deputy

371140010